

JAN 21 1999

**CASS COUNTY REMONUMENTATION  
LAND CORNER RECORDATION CERTIFICATE  
Filing Requirement of Act 74, Mich. P.A. 1970**

SECTION

For corners in **CASS COUNTY** Located in: **SILVER CREEK TWP.** Corner Code # **(A-8) W1/4 CORNER SEC.19**

- 1. Public Land Survey T 5S R 16W A-8
- \_\_\_\_\_ T \_\_\_\_\_ R \_\_\_\_\_
- \_\_\_\_\_ T \_\_\_\_\_ R \_\_\_\_\_
- \_\_\_\_\_ T \_\_\_\_\_ R \_\_\_\_\_
- 2. Property Controlling S \_\_\_\_\_ T \_\_\_\_\_ R \_\_\_\_\_
- in Section S \_\_\_\_\_ T \_\_\_\_\_ R \_\_\_\_\_
- 3. Miscellaneous S \_\_\_\_\_ T \_\_\_\_\_ R \_\_\_\_\_
- Property in Sec. S \_\_\_\_\_ T \_\_\_\_\_ R \_\_\_\_\_
- 4. Lot No \_\_\_\_\_, Recorded Plat \_\_\_\_\_
- 5. Private Claims \_\_\_\_\_

STATE OF MICHIGAN  
COUNTY OF CASS  
Recorded

12-22-1998 15:40:17

Ann L. Simmons  
REGISTER OF DEEDS

Register of Deeds Stamp & File Number

Ratified by Peer Group  
 In Accordance With P.A. 345  
 Chairman *[Signature]*  
 M.A. 79. 1998

I, **Alan Bartlett** in a field survey on **November 16, 1998** hereby certify that under requirements of P.A. 74, Michigan P.A. of 1970, the corner points mentioned in lines 1 and 2 above were in conformance with regulations and rules therefore as required in the current manual of survey instructions of the United States Department of the Interior, Bureau of Land Management or by a decree of a Court of Law and/or that the corner points mentioned in lines 3, 4 and 5 above were in conformance with the rules of the Michigan Board of Land Surveyors or by a Decree of a Court of Law; established, re-established, monumented, re-monumented, recovered, found as expressed below:

**NOTE: Not more than 4 corners, all in the same town and range, may be recorded on this certificate.**

	A	B	C	D	E	F	G	H	I	J	K	L	M
2	6	5	4	3	2	1							
3													
4	7	8	9	10	11	12							
5													
6	18	17	16	15	14	13							
7													
8	19	20	21	22	23	24							
9													
10	30	29	28	27	26	25							
11													
12	31	32	33	34	35	36							
13													

A. Description of original monument and accessories and/or subsequent restoration:

(NOT SET BY ORIGINAL GOVERNMENT SURVEY)

(PLEASE SEE BACK PAGE)

Liber **00003** Page **0189**

B. Description of corner evidence found and/or method applied in restoring or reestablishing corner:

Corner not set by original government survey. Found Iron Pipe inside 2' Iron Pipe 2" below Asphalt 8' West of Center Line of Brush Lake Road. This Corner was established using existing witnesses and approved by the Cass County Remonumentation Peer Group of Surveyors on October 29, 1998


C. Description of monument for corner and accessories established to perpetuate locating the position of the corner:

Set Cass County Remonumentation cap and Galvanized Pipe in Monument Box 8' West of Center Line of Brush Lake Road. Monument set on Township Line.

	Witnesses	
S50W	Top Center of Phone Riser	33.09'
N10W	Set Nail and Flasher SW side 16" Pine	63.01'
North	Fnd P.K. Nail in E. side 14" Pine	65.95'
North	Berrien County Mon. M-8	37.18'

This position not established by original government surveyors. This monument is accepted as the best available evidence of the position of the corner.

Signed by *Alan K. Bartlett* Date 12/16/98  
 Surveyor's Michigan License No. 35988

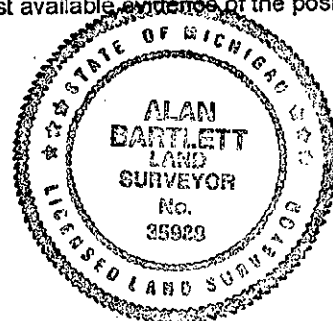

**A-8 W 1/4 CORNER SECTION 19 SILVER CREEK TWP. T5S, R16W (not GLO corner)**

**Robert Prestine** (no dates, Misc. Notes)  
Found 1/2" Iron Pipe Capped

**Witnesses**

SW corner of house	N28E	113.6'
8" Cherry	S60E	40.3'
Pole	N43W	33.85'
8" Pine	North	66.0'

Jog = 37.15'

**Southwest Surveys 1979** Deep, set 1/2" iron rod over

**Barger Engineering 8/17/81 (Prestine)**

Survey shows:  
Jog 37.15'  
Found 5/8" Iron Pipe'

**Landmark Technologies 1998**

**Alan Bartlett RLS# 35988**

Found Iron Pipe Inside 2" Iron Pipe 8' west of C/L Brush Lake Rd.

North	PK in 14" Pine	65.95'
North	End. Rebar	37.18'
N10W	Set nail in 16" Pine	63.02'
S50W	Top c/l Phone Riser	33.09'

Liber 00003 Page 0190

**SURVEY &  
REMONUMENTATION**

**JAN 21 1999**

**SECTION**