

APR 26 1995

COMMISSION

LAND CORNER RECORDATION CERTIFICATE

Filing Requirement of Act 74, Mich. P.A. 1970

STATE OF MICHIGAN  
CASS COUNTY  
RECEIVED FOR RECORD

1994 DEC 29 PM 4 21

For corners in  
CASS  
(County)

Located In: CASS COUNTY, REMONUMENTATION  
Corner Code F-1

- |                         |   |    |   |     |     |
|-------------------------|---|----|---|-----|-----|
| 1. Public Land Survey   | T | 5S | R | 16W | F-1 |
| N 1/4 Cor. Section 4    | T |    | R |     |     |
|                         | T |    | R |     |     |
|                         | T |    | R |     |     |
| 2. Property Controlling | S |    | T | R   |     |
| in Section              | S |    | T | R   |     |
| 3. Miscellaneous        | S |    | T | R   |     |
| Property in Sec.        | S |    | T | R   |     |

*Anna L. Simmons*  
CLERK/REGISTER

LIBER 2 PAGE 393

Register of Deeds Stamp & File Number

Ratified by Peer Group  
 In Accordance With P.A. 345  
 Chairman *Dale Kesler*  
 No. 77 100

4. Lot No. \_\_\_\_\_, Recorded Plat \_\_\_\_\_  
 5. Private Claims \_\_\_\_\_

	A	B	C	D	E	F	G	H	I	J	K	L	M
2	6		5		4	3		2		1			
3													
4	7		8		9	10		11		12			
5													
6	18		17		16	15		14		13			
7													
8	19		20		21	22		23		24			
9													
10	30		29		28	27		26		25			
11													
12	31		32		33	34		35		36			
13													

I, Dale L. Kesler, in a field survey on December 21, 19 94  
do hereby certify that under requirements of P.A. 74, Michigan P.A. of 1970, the corner points mentioned  
in lines 1 and 2 above were in conformance with regulations and rules therefore as required in the  
current manual of survey instructions of the United States Department of the Interior, Bureau of Land  
Management or by a decree of a Court of Law and/or that the corner points mentioned in lines 3, 4 and 5  
above were in conformance with the rules of the Michigan Board of Land Surveyors or by a Decree of a  
Court of Law; established, re-established, monumented, re-monumented, recovered, found as  
expressed below:


**NOTE: Not more than 4 corners, all in the same town and range, may be recorded on this certificate.**

A. Description of original monument and accessories and/or subsequent restoration:  
 This corner was not set by Government

- 1878 Amos Smith (County Surveyor) set post - Accessories - 16" White Oak - South 2 1/2° East - 28 Links, 15" White Oak - South 39 1/2° West - 22 Links
- July 1926 - Woodlawn Subdivision point of beginning is the same
- Jan. 1941 - Krohne's Peninsula Subdivision point of beginning is the same.

B. Description of corner evidence found and/or method applied in restoring or reestablishing corner:  
 Found concrete monument. Measures Plat distance to Lot corners in Krohne's Peninsula Subdivision. Accepted concrete monument as best evidence of corner.

C. Description of monument for corner and accessories established to perpetuate locating the position of the corner:  
 Set 3/4" standard 2' iron pipe with aluminum cap in monument box in place of existing concrete monument and is accepted as a careful and faithful perpetuation of the original corner.  
 Found 1/2" iron - East 33.00'  
 Set nail with washer in 30" Oak tree - South 45° West 14.10'  
 Set nail with washer in 36" Oak tree - South 12° West - 44.55'  
 Set nail with washer in 16" Oak tree - East - 37.75'

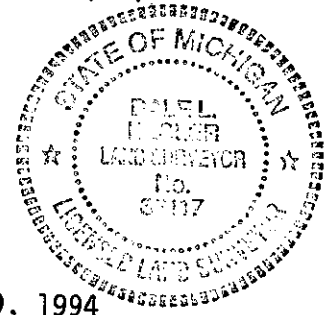

Signed by *Dale Kesler* Date December 29, 1994  
 Surveyor's Michigan License No. 38117