

**SURVEY
REMONUMENTATION**

APR 26 1995

COMMISSION

For corners in

CASS
(County)

LAND CORNER RECORDATION CERTIFICATE

Filing Requirement of Act 74, Mich. P.A. 1970

CASS COUNTY REMONUMENTATION

Located In: Corner Code #

1. Public Land Survey SE Cor. Section 9	T 5S R 16W	G-5
	T _____ R _____	_____
	T _____ R _____	_____
	T _____ R _____	_____
2. Property Controlling in Section	S _____ T _____ R _____	_____
	S _____ T _____ R _____	_____
3. Miscellaneous Property in Sec.	S _____ T _____ R _____	_____

STATE OF MICHIGAN
CASS COUNTY
RECEIVED FOR RECORD

1994 DEC 29 PM 4 22

Ann E. Simmons
CLERK/REGISTER

LIBER 2 PAGE 396


Register of Deeds Stamp & File Number

Retified by Pacer Group
In Accordance with P.A. 245
Chairman *Dale Kesler*
Date *Dec 22, 1994*

- 4. Lot No. _____, Recorded Plat _____
- 5. Private Claims _____

I, Dale L. Kesler, in a field survey on December 20, 19 94

do hereby certify that under requirements of P.A. 74, Michigan P.A. of 1970, the corner points mentioned in lines 1 and 2 above were in conformance with regulations and rules therefore as required in the current manual of survey instructions of the United States Department of the Interior, Bureau of Land Management or by a decree of a Court of Law and/or that the corner points mentioned in lines 3, 4 and 5 above were in conformance with the rules of the Michigan Board of Land Surveyors or by a Decree of a Court of Law; established, re-established, monumented, re-monumented, recovered, found as expressed below:

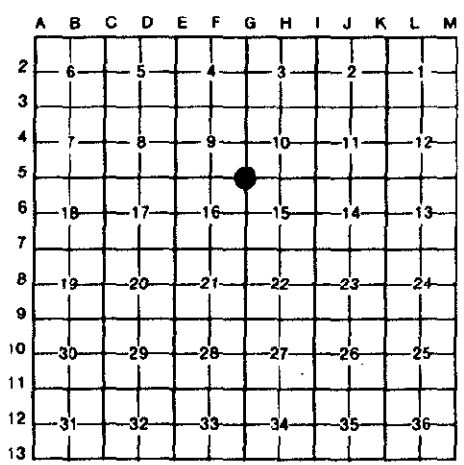

NOTE: Not more than 4 corners, all in the same town and range, may be recorded on this certificate.

A. Description of original monument and accessories and/or subsequent restoration:

- 1830 - Government Surveyor J. Mullett set wood post
18" White Oak North 83° East - 40 Links, 8" White Oak South 45° East - 11 Links
- 1880 Amos Smith - Stone and brickbats over post
- Apr. 1973 - Robert Prestine - L.C.R.C. Liber 1, Page 153 - Found 1/2" iron pipe
Centerline Electric pole South 18° West - 96.8', Centerline 14" Walnut North 73°
East - 101.5', 5' ± West of North and South Road, 2' ± South of East & West Road.

B. Description of corner evidence found and/or method applied in restoring or reestablishing corner:

Found 1/2" iron pipe in monument box at the Southeast corner of Section 9.
Witnesses recorded in Liber 1, Page 153, measured to the found 1/2" iron pipe.

Accepted 1/2" iron pipe as best evidence of corner.

C. Description of monument for corner and accessories established to perpetuate locating the position of the corner:

- Set 3/4" standard 2' iron pipe with aluminum cap in place of found 1/2" iron pipe and is accepted as a careful and faithful perpetuation of the original Corner.
- Set PK nail with washer West side in Electric pole - South 18° West - 96.8'
- Set PK nail with washer South side in 14" Walnut - North 73° East - 101.50'
- 5' ± West of Centerline of North & South Road
- 2' ± South of Centerline of East & West Road
- Set nail with washer Northside in 105" Ash - South 75° West - 68.0'

ed by *Dale L. Kesler*
or's Michigan License No. 38117

Date December 29, 1994

