

LAND CORNER RECORDATION CERTIFICATE

FILING REQUIREMENT OF ACT 74, MICH. P.A.1970

FOR CORNERS OF--:	LOCATED IN--:	CORNER CODE NUMBER
1. PUBLIC LAND SURVEY <u>31</u> T. <u>6</u> S., R. <u>13</u> W.		A-13, B-11, B-13
2. PROPERTY CONTROLLING IN SECTION _____, T. _____, N. S., R. _____, E. W.		
3. MISCELLANEOUS PROPERTY IN SECTION _____, T. _____, N. S., R. _____, E. W.		
4. LOT NO. _____, RECORDED PLAT _____		
5. PRIVATE CLAIMS _____		

REGISTER OF DEEDS STAMP AND FILING NUMBER

I, Russell L. Roon, do hereby certify that under requirements of P.A. 74, Michigan P.A. of 1970, the corner points mentioned in lines 1 and 2 above were, in a field survey on June, 1978, established, re-established, monumented, re-monumented, recovered or restored as expressed below and in conformance with regulations and rules therefore as required in the current manual of survey instructions of the United States Department of the Interior, Bureau of Land Management or by a decree of a court of law. Furthermore, that the corner points mentioned in lines 3, 4 and 5 above were, in a field survey on _____, 19____, found, recovered, restored, established or re-established as expressed below and in conformance with the rules of the Michigan State Board of Registration for Land Surveyors or, by a Decree of a Court of law:

- A. Description of original monument and accessories and/or subsequent restoration:
- | | |
|---|--|
| <p>A-13
1" x 24" iron over stone set by Robert W. Prestine
Nail in 8" Hickory, West, 56.4
Nail in telephone pole, N 35° E, 48.05'
Nail in electric pole, S 60° E, 55.5'</p> | <p>B-13
1/2" x 16" iron pipe over 3/8" iron set by Robert W. Prestine
Nail in 36" Oak - N 65° E - 37.05'
3/8" Iron - North - 33.0'
1/2" Iron - East - 84.63'</p> |
|---|--|

- B. Description of corner evidence found and/or method applied in restoring or re-establishing corner:
- | | | |
|---------------------------------|--|---------------------------------|
| <p>A-13
Found 3/4" Pipe</p> | <p>B-11
Found iron in pavement as shown on highway R.O.W. map.</p> | <p>B-13
Found 1/2" pipe</p> |
|---------------------------------|--|---------------------------------|

- C. Description of monument for corner and accessories established to perpetuate locating the position of the corner:
- | | | |
|--|---|--|
| <p>A-13
3/4" Pipe
8" Hickory - N 88° W - 56.48'
16" Hickory - N 11° E - 93.89'
Power Pole - S 60° E - 55.55'</p> | <p>B-11
Iron in pavement.
C M-60 - North - 2.95
22" Hickory - N 72° E - 131.61'
24" Walnut - South - 85.90'
"+" in sta. 248 + 00 - S 80° E - 58.35'</p> | <p>B-13
1/2" Pipe
37" Oak - N 66° E - 37.00'</p> |
|--|---|--|


SIGNED BY _____ DATE _____

SURVEYOR'S MICHIGAN REGISTRATION NO. _____ (SEAL)

FOR STATE AND UNITED STATES AGENCIES:

SIGNED BY _____ DATE _____

APPROVED AND SIGNED BY Russell L. Roon CHIEF OF SURVEY PARTY DATE 9-17-80
MICHIGAN REGISTERED LAND SURVEYOR

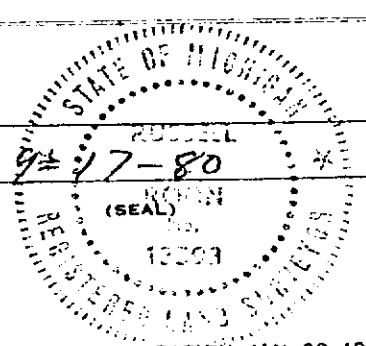

SURVEYOR'S MICHIGAN REGISTRATION NO. 13593