

JAN 21 1999

LAND CORNER RECORDATION CERTIFICATE
Filing Requirement of Act 74, Mich. P.A. 1970
Cass County Remonumentation

STATE OF MICHIGAN
COUNTY OF CASS
Recorded

SECTION

Form with fields: For corners in Cass (County), Located In: T 6S R 13W, Corner Code # M-2. Includes sections for Public Land Survey, Property Controlling, and Miscellaneous Property.

12-22-1998 15:49:03

Ann L. Simmons
REGISTER OF DEEDS

Vertical text: Ratified by Peer Group In Accordance With P.A. 345 Chairman

Register of Deeds Stamp & File Number

4. Lot No. , Recorded Plat
5. Private Claims

I, DALE L. KESLER, in a field survey on June 17, 1998 do hereby state that under requirements of P.A. 74, Michigan P.A. of 1970, the corner points mentioned in lines 1 and 2 above were in conformance with regulations and rules therefore as required in the current manual of survey instructions of the United States Department of the Interior, Bureau of Land Management or by a decree of a Court of Law and /or that the corner points mentioned in lines 3, 4 and 5 above were in conformance with the rules of the Michigan Board of Land Surveyors or by a Decree of a Court of Law; established, re-established, monumented, recovered, found as expressed below:

NOTE: Not more than 2 corners, all in the same town and range, may be recorded on this certificate.

A. Description of original monument and accessories and/or subsequent restoration:

*March 8, 1827 William Brookfield - Set 1/4 post. Witness: 15" White Oak N.73 1/2 degrees W 65 feet.


B. Description of corner evidence found and/or method applied in restoring or reestablishing corner:

Nothing was found at this corner. Reestablished corner by proration between the Northeast corner and Southeast corner of Section 1, T6S, R13W.

C. Description of monument for corner and accessories established to perpetuate locating the position of the corner:

Set 3/4" iron pipe 24" long with aluminum cap in monument box and is accepted as a careful and faithful reestablishment of the position of the original corner.

- PK Nail & Washer in West side 12" Cedar North 5 degrees East 42.18'
PK Nail & Washer in South side 26" Hickory North 68 degrees East 36.20'
PK Nail & Washer in South side 28" White Pine North 80 degrees East 76.16'
Centerline East-West Gravel Road South 2.5'
W 1/4 Corner Section 6, T6S, R12W South 15.84'

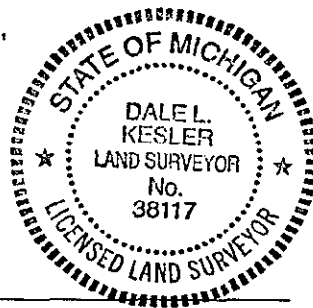

Signed by Dale Kesler
Surveyor's Michigan License No. 38117

Date Dec 22, 1998

Grid table with columns A-M and rows 1-13. Contains numbers 1-36 in a grid pattern.