

JAN 21 1999

Liber 00003 Page 0199

LAND CORNER RECORDATION CERTIFICATE
Filing Requirement of Act 74, Mich. P.A. 1970
Cass County Remonumentation

STATE OF MICHIGAN
COUNTY OF CASS
Recorded

SECTION

Form with fields: For corners in Cass (County), Located In: T 6S R 13W, Corner Code # M-4. Includes sections for Public Land Survey, Property Controlling, and Miscellaneous Property.

12-22-1998 15:49:17

Ann L. Simmons
REGISTER OF DEEDS

Notarized by Peer Group
In Accordance With P.A. 345
Chairman Dale Kesler

Register of Deeds Stamp & File Number

4. Lot No. , Recorded Plat
5. Private Claims

I, DALE L. KESLER, in a field survey on June 30, 1998 do hereby state that under requirements of P.A. 74, Michigan P.A. of 1970, the corner points mentioned in lines 1 and 2 above were in conformance with regulations and rules therefore as required in the current manual of survey instructions of the United States Department of the Interior, Bureau of Land Management or by a decree of a Court of Law and /or that the corner points mentioned in lines 3, 4 and 5 above were in conformance with the rules of the Michigan Board of Land Surveyors or by a Decree of a Court of Law; established, re-established, monumented, recovered, found as expressed below:

Grid table with columns A-M and rows 1-13. Contains numbers 1-36 in a grid pattern.

NOTE: Not more than 2 corners, all in the same town and range, may be recorded on this certificate.

A. Description of original monument and accessories and/or subsequent restoration:

\*June 25, 1828 Calvin Britain - Set Section Post. Witness: 11" White Oak N 77° W 86 links, 10" White Oak S 21° W 114 links.

No other history was found of this corner.


B. Description of corner evidence found and/or method applied in restoring or reestablishing corner:

Found nothing at this corner. Reestablished this corner by single proportionment measurement by using the Northeast corner of Section 12 and the Southeast corner of Section 12. Corner is in an old fence line running North and South.

C. Description of monument for corner and accessories established to perpetuate locating the position of the corner:

Set 3" concrete monument 36" long with aluminum cap and is accepted as a careful and faithful reestablishment of the position of the original corner.

- W 1/4 Corner Section 7, T6S, R12W South 17.34'
PK Nail with washer North side 9" Elm South 35 degrees West 23.48'
PK Nail with washer South side 18" Oak North 80 degrees West 20.11'
PK Nail with washer East side 22" Oak North 7.82'

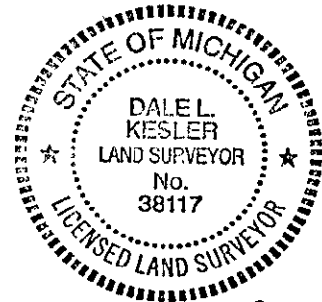

Signed by Dale L Kesler

Date Dec 22, 1998

Surveyor's Michigan License No. 38117