

# SURVEY & REMONUMENTATION

APR 26 1995

COMMISSION

STATE OF MICHIGAN  
CASS COUNTY  
RECEIVED FOR RECORD

## LAND CORNER RECORDATION CERTIFICATE

Filing Requirement of Act 74, Mich. P.A. 1970

CASS COUNTY REMONUMENTATION

1994 NOV 8 PM 2 53

For corners in

CASS

(County)

Located In:

Corner Code #

- |                                    |   |   |   |    |      |
|------------------------------------|---|---|---|----|------|
| 1. Public Land Survey              | T | 6 | R | 14 | F-13 |
|                                    | T |   | R |    |      |
|                                    | T |   | R |    |      |
|                                    | T |   | R |    |      |
| 2. Property Controlling in Section | S |   | T | R  |      |
|                                    | S |   | T | R  |      |
| 3. Miscellaneous Property in Sec.  | S |   | T | R  |      |
|                                    | S |   | T | R  |      |

*Anna L. Simmons*  
CLERK/REGISTER

LICER 2 PAGE 356

Register of Deeds Stamp & File Number

Ratified by Peer Group  
In Accordance With P.A. 245

4. Lot No. \_\_\_\_\_, Recorded Plat \_\_\_\_\_
5. Private Claims \_\_\_\_\_

	A	B	C	D	E	F	G	H	I	J	K	L	M
2	6	5	4	3	2	1							
3													
4	7	8	9	10	11	12							
5													
6	13	17	16	15	14	13							
7													
8	19	20	21	22	23	24							
9													
10	30	29	28	27	26	25							
11													
12	31	32	33	34	35	36							
13													

I, Dale L. Kesler, in a field survey on October 6, 19 94, do hereby certify that under requirements of P.A. 74, Michigan P.A. of 1970, the corner points mentioned in lines 1 and 2 above were in conformance with regulations and rules therefore as required in the current manual of survey instructions of the United States Department of the Interior, Bureau of Land Management or by a decree of a Court of Law and/or that the corner points mentioned in lines 3, 4 and 5 above were in conformance with the rules of the Michigan Board of Land Surveyors or by a Decree of a Court of Law; established, re-established, monumented, re-monumented, recovered, found as expressed below:

**NOTE: Not more than 4 corners, all in the same town and range, may be recorded on this certificate.**

**A. Description of original monument and accessories and/or subsequent restoration:**

1828 - Calvin Britain set post - accessories 11" Beech S.76° E. 46 Lks., 5" Beech S. 64° W. 57 Lks.; 1876 - Identified by Amos Smith - set Tamarack stake - accessories, 28" Black Walnut N. 73-1/2° E. 371 Lks, 20" Black Ash N. 2-3/4° E.; 1882 - F. E. Smith, found post.


**B. Description of corner evidence found and/or method applied in restoring or reestablishing corner:**

Found nothing, set corner by single proportion measurement between the southeast corner of Section 33, T. 6 S., R. 14 W. and the southwest corner of Section 33, T. 6 S., R. 14 W.

**C. Description of monument for corner and accessories established to perpetuate locating the position of the corner:**

Set standard 2" iron pipe w/aluminum cap (in swamp) and accepted as a careful and faithful reestablishment of the position of the original corner.

- N. 1/4 Corner, Section 4, T. 7 S. R. 14 W. ( monument w/cap) West 0.66'
- Set PK nail w/washer, in 14" Maple N.15° W. 27.02'
- Set PK nail w/washer, in 14" Maple S.74° W. 15.48'
- Set PK nail w/washer, in 12" Maple S.65° E. 10.93'

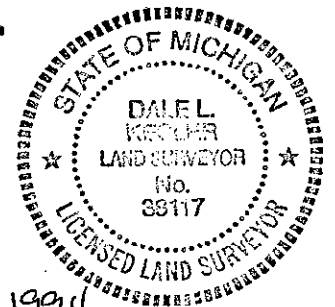

Signed by *Dale L. Kesler*  
Surveyor's Michigan License No. No. 38117

Date November 8, 1994