

CASS COUNTY REMONUMENTATION

LAND CORNER RECORDATION CERTIFICATE

Filing Requirement of Act 74, Mich. P.A. 1970

STATE OF MICHIGAN  
CASS COUNTY  
RECEIVED FOR RECORD

1994 JUL 12 AM 8 41

For corners in

Cass (County)	Located in:	Corner Code #
1. Public Land Survey	T 6 S R 14 W	M-13 (SE Cor., 36) Penn Twp.
2. Property Controlling in Section	S T R	(NE Cor., 1) Calvin Twp.
3. Miscellaneous Property in Sec.	S T R	COMMON CORNER

*Ann K. Simmons*  
CLERK/REGISTER

LIBER 2 PAGE 347

Register of Deeds Stamp & File Number

Chairman Dale C. Kesler  
Date 7-14-94  
Ratified by Peer Group  
In Accordance With P.A. 345

4. Lot No. \_\_\_\_\_, Recorded Plat \_\_\_\_\_  
5. Private Claims \_\_\_\_\_

I, Chris F. Marbach, in a field survey on May 11, 19 94, do hereby certify that under requirements of P.A. 74, Michigan P.A. of 1970, the corner points mentioned in lines 1 and 2 above were in conformance with regulations and rules therefore as required in the current manual of survey instructions of the United States Department of the Interior, Bureau of Land Management or by a decree of a Court of Law and/or that the corner points mentioned in lines 3, 4 and 5 above were in conformance with the rules of the Michigan Board of Land Surveyors or by a Decree of a Court of Law; established, re-established, monumented, re-monumented, recovered, found as expressed below:

**NOTE: Not more than 4 corners, all in the same town and range, may be recorded on this certificate.**

	A	B	C	D	E	F	G	H	I	J	K	L	M
2	6	5	4	3	2	1							
3													
4	7	8	9	10	11	12							
5													
6	18	17	16	15	14	13							
7													
8	19	20	21	22	23	24							
9													
10	30	29	28	27	26	25							
11													
12	31	32	33	34	35	36							
13													

A. Description of original monument and accessories and/or subsequent restoration:

M-13, Original Monument: Post (Britain, 1828)

Accessories: 15" Oak N60½°W, 1.67lks. (1.10')  
13" Oak N58°E, 1.53lks. (1.01')

Subsequent Observations (as per survey): 1" iron over stone (Prestine, 1978)  
¾" iron pipe (Wightman-Peirce, 1987)  
½" iron pipe in box (Wightman-Peirce, 1990)  
¾" iron pipe (Wightman-Peirce, 1993)


B. Description of corner evidence found and/or method applied in restoring or reestablishing corner:

M-13, Found iron pipe in box.

Corner perpetuated by the following surveys:

Distance from S¼ Cor. Sec. 36, T6S, R14W (as per survey)  
2651.01' (Wightman-Peirce, 1993)  
2651.15' (Marbach & Brady, 1994)

Distance from S¼ Cor. Sec. 31, T6S, R13W (as per survey)  
2393.33' (Prestine, 1978)  
2392.99' (Marbach & Brady, 1994)

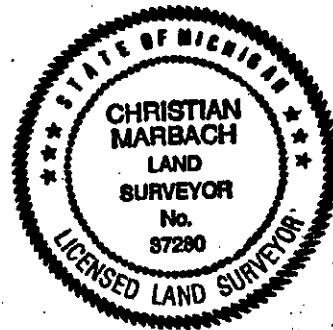

C. Description of monument for corner and accessories established to perpetuate locating the position of the corner:

M-13, Monument: 1" iron pipe with aluminum tablet set in 8" dia. monument box.

Witnesses: P.K. & cap in W. Side telephone pole; N41°E, 52.65'  
P.K. & cap in SW Side powerpole; S60°E, 55.72'  
(all measured with tape) P.K. & cap in E. Side 24" Hickory; S18°W, 96.56'  
P.K. & cap in S. Side 12" Hickory; N85°W, 56.26'  
P.K. nails set 2' North & 2' West

Signed by *Chris F. Marbach*

Date July 5, 1994

Surveyor's Michigan License No. 37280