

**REMONUMENTATION**

APR 26 1995

**COMMISSION**

**LAND CORNER RECORDATION CERTIFICATE**

Filing Requirement of Act 74, Mich. P.A. 1970

CASS COUNTY REMONUMENTATION

STATE OF MICHIGAN  
DEPT. OF LAND & WATER

1994 DEC 29 PM 4 23

For corners in

CASS  
(County)

Located In:

Corner Code #

1. Public Land Survey SW Cor. Section 30	T 6S R 15W	A-11
	T R	
	T R	
	T R	
2. Property Controlling in Section	S T R	
	S T R	
3. Miscellaneous Property in Sec.	S T R	
	S T R	

*Dale L. Kesler*  
CLERK/REGISTER

LIBER 2 PAGE 411

Register of Deeds Stamp & File Number

Ratified by Peer Group

In Accordance With P.A. 345

Chairman *Dale L. Kesler*

Date *Dec 22, 1994*

4. Lot No. \_\_\_\_\_, Recorded Plat \_\_\_\_\_  
5. Private Claims \_\_\_\_\_

A	B	C	D	E	F	G	H	I	J	K	L	M
2	6	5	4	3	2	1						
3												
4	7	8	9	10	11	12						
5												
6	18	17	16	15	14	13						
7												
8	19	20	21	22	23	24						
9												
10	30	29	28	27	26	25						
11												
12	31	32	33	34	35	36						
13												

I, Dale L. Kesler, in a field survey on December 15, 19 94, do hereby certify that under requirements of P.A. 74, Michigan P.A. of 1970, the corner points mentioned in lines 1 and 2 above were in conformance with regulations and rules therefore as required in the current manual of survey instructions of the United States Department of the Interior, Bureau of Land Management or by a decree of a Court of Law and/or that the corner points mentioned in lines 3, 4 and 5 above were in conformance with the rules of the Michigan Board of Land Surveyors or by a Decree of a Court of Law; established, re-established, monumented, re-monumented, recovered, found as expressed below:

**NOTE: Not more than 4 corners, all in the same town and range, may be recorded on this certificate.**

A. Description of original monument and accessories and/or subsequent restoration:

Jan. 1827 - William Brookfield - Set corner to Sections 25 and 36; 80 Chains north of Township corner, then West on line between Sections 30 and 31; 40.00 Chains West, then 42.58 Chains to intersection of West boundary 49 Links South of post. Set corner to 30 and 31. - 5" Beech North 14° East - .5 Chains  
11" Lynn - South 22 1/2° East - .43 Chains  
Apr. 1872 - J.C. Bradt - County Surveyor - Corner lost - Established and set stone 42.42 Chains west of South 1/4 Sec. 30 and 82.21 Chains West of Southeast Corner of Section 30. No Witnesses.


(Over)

B. Description of corner evidence found and/or method applied in restoring or reestablishing corner:

Found standard monument not in monument box for the Southwest corner of Section 30, T6S, R15W. Accepted standard monument as best evidence of corner.

C. Description of monument for corner and accessories established to perpetuate locating the position of the corner:

Set 3/4" standard 2' iron pipe with aluminum cap in monument box in place of standard monument and is accepted as a careful and faithful perpetuation of the original corner.  
Set PK nail with washer in power pole - South 67.90'  
Centerline road - North 16.00'  
Center telephone riser - North 55° West - 84.15'  
Northeast corner Section 36-6-16 - North 32.36'

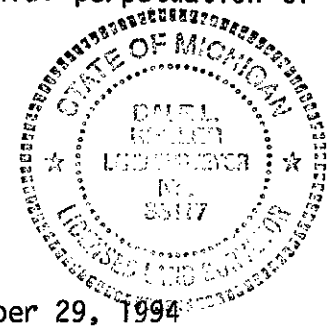

Signed by *Dale L. Kesler* Date December 29, 1994

Surveyor's Michigan License No. 38117

A. (Continued)

Oct. 1978 - H. D. Peirce - Recorded corner Liber 2, Page 124 -  
Set standard monument in existing monument box.  
Power pole - South  $2^{\circ}$  East - 67.05'  
Northeast corner Section 36-6-16 - North 32.36'

LIBER 2 PAGE 412