

Ratified by Peer Group  
In Accordance With P.A. 345

Chairman Dale Kahn  
Date December 20, 1995  
For corners in

Liber 00003 Page 0051

CASS COUNTY REMONUMENTATION  
**LAND CORNER RECORDATION CERTIFICATE**  
Filing Requirement of Act 74, Mich. P.A. 1970

STATE OF MICHIGAN  
COUNTY OF CASS  
Recorded

12-28-1995 16:12:20

Ann L. Simmons  
REGISTER OF DEEDS

Register of Deeds Stamp & File Number

CASS (County)	Located In:	Corner Code #
1. Public Land Survey	T <u>6 S</u> R <u>15 W</u>	<u>C-12</u>
	T ___ R ___	_____
	T ___ R ___	_____
	T ___ R ___	_____
2. Property Controlling in Section	S ___ T ___ R ___	_____
	S ___ T ___ R ___	_____
3. Miscellaneous Property in Sec.	S ___ T ___ R ___	_____
	S ___ T ___ R ___	_____
4. Lot No. _____, Recorded Plat _____		
5. Private Claims _____		

	A	B	C	D	E	F	G	H	I	J	K	L	M
2	6	5	4	3	2	1							
3													
4	7	8	9	10	11	12							
5													
6	18	17	16	15	14	13							
7													
8	19	20	21	22	23	24							
9													
10	30	29	28	27	26	25							
11													
12	31	32	33	34	35	36							
13													

I, Robert W. Prestine, in a field survey on December 7, 1995, do hereby certify that under requirements of P.A. 74, Michigan P.A. of 1970, the corner points mentioned in lines 1 and 2 above were in conformance with regulations and rules therefore as required in the current manual of survey instructions of the United States Department of the Interior, Bureau of Land Management or by a decree of a Court of Law and/or that the corner points mentioned in lines 3, 4 and 5 above were in conformance with the rules of the Michigan Board of Land Surveyors or by a Decree of a Court of Law; established, re-established, monumented, re-monumented, recovered, found as expressed below:

NOTE: Not more than 4 corners, all in the same town and range, may be recorded on this certificate.

A. Description of original monument and accessories and/or subsequent restoration:

C-12 East quarter corner Section 31, T. 6 S., R. 15 W.  
Govt wits gone  
Wm. Brookfield D.S. March 1828  
Lynn 10" N 76° W 18 links  
Cherry 13" N 29½° E 21 links  
Cass Co. Road Comm. Elm 12" N 78-3/4° E 60.0'


STATE OF MICHIGAN  
REGISTER OF DEEDS  
MAR 27 1996  
COMMISSION

B. Description of corner evidence found and/or method applied in restoring or reestablishing corner:

C-12  
Set 3/4" x 24" iron on line & halfway between N.E. corner & S.E. corner.  
2626.6' from each corner.  
Found corner by others 19.35' South & 1.8' East

Description of monument for corner and accessories established to perpetuate locating the position of the corner:

C-12 Set 3/4" x 24" iron & remon cap in monument box.  
Nail & washer in South side Elec. Pole S 65° E 50.9'  
Nail & washer in North side 17" Ash N 60° W 28.5'  
S.E. corner Tele. Pedestal N 18° W 67.45'  
Nail & washer in North side 15" Maple S 88° W 27.45'  
4'± West of center of North & South Road  
This position is accepted as a careful and faithful reestablishment of the position of the original corner.

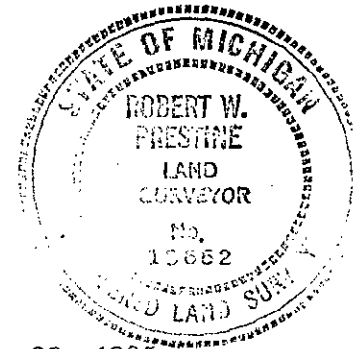

Witnessed by Robert W. Prestine Date December 28, 1995  
Surveyor's Michigan License No. 18662