

Ratified by Peer Group

In Accordance With P.A. 345

Chairman Dale C. Keeler

Date December 20, 1995

For corners in

CASS COUNTY REMONUMENTATION  
LAND CORNER RECORDATION CERTIFICATE  
Filing Requirement of Act 74, Mich. P.A. 1970

Liber 00003 Page 0052

STATE OF MICHIGAN  
COUNTY OF CASS  
Recorded

12-28-1995 16:12:31

Ann L. Simmons  
REGISTER OF DEEDS

Register of Deeds Stamp & File Number

CASS (County)	Located In:	Corner Code #
1. Public Land Survey	T 6 S R 15 W	C-13
	T ___ R ___	_____
	T ___ R ___	_____
	T ___ R ___	_____
2. Property Controlling in Section	S ___ T ___ R ___	_____
	S ___ T ___ R ___	_____
3. Miscellaneous Property in Sec.	S ___ T ___ R ___	_____
	S ___ T ___ R ___	_____
4. Lot No. _____, Recorded Plat _____		
5. Private Claims _____		

	A	B	C	D	E	F	G	H	I	J	K	L	M
2	6	5	4	3	2	1							
3													
4	7	8	9	10	11	12							
5													
6	18	17	16	15	14	13							
7													
8	19	20	21	22	23	24							
9													
10	30	29	28	27	26	25							
11													
12	31	32	33	34	35	36							
13													

I, Robert W. Prestine, in a field survey on December 7, 1995, do hereby certify that under requirements of P.A. 74, Michigan P.A. of 1970, the corner points mentioned in lines 1 and 2 above were in conformance with regulations and rules therefore as required in the current manual of survey instructions of the United States Department of the Interior, Bureau of Land Management or by a decree of a Court of Law and/or that the corner points mentioned in lines 3, 4 and 5 above were in conformance with the rules of the Michigan Board of Land Surveyors or by a Decree of a Court of Law; established, re-established, monumented, re-monumented, recovered, found as expressed below:

NOTE: Not more than 4 corners, all in the same town and range, may be recorded on this certificate.

A. Description of original monument and accessories and/or subsequent restoration:

C-13 Southeast corner Section 31, T. 6 S., R. 15 W.  
Govt wits gone  
W.M. Brookfield D.S. March 1828  
White Oak 22" N 17° E 44 links  
White Oak 24" N 82½° W 1.11 chains

MAR 27 1996


COMMISSION

B. Description of corner evidence found and/or method applied in restoring or reestablishing corner:

C-13  
Found standard Cass County corner.  
Corner is S 80° E 2.3' from small stone.

Description of monument for corner and accessories established to perpetuate locating the position of the corner:

C-13 Set 4" round Cass County Remonumentation monument.  
Nail & washer is South side 14" Pine N 68° E 69.2'  
S.E. corner of base Pettigrew monument in Cemetery N 15° W 48.1'  
S.W. corner J.E. Whitmore monument N 40° E 61.7'  
Fence line (E. & W. ) South 4.2'  
234.7' East of N.E. corner Section 6-7-15  
This position is accepted as a careful and faithful reestablishment of the position of the original corner.

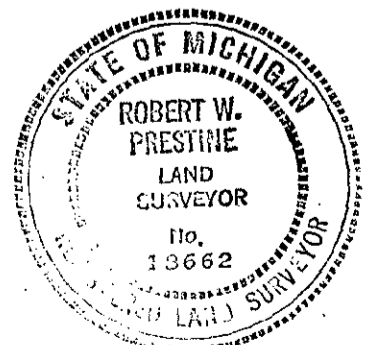

by Robert W. Prestine

Date December 28, 1995

Surveyor's Michigan License No. 18662