

**SURVEY & REMONUMENTATION**

FEB 19 1998

Liber **00003** Page **0126**

**LAND CORNER RECORDATION CERTIFICATE**  
**Filing Requirement of Act 74, Mich. P.A. 1970**  
**CASS COUNTY REMONUMENTATION**

STATE OF MICHIGAN  
 COUNTY OF CASS  
 Recorded

12-26-1997 11:55:26

Ann L. Simmons  
 REGISTER OF DEEDS

Validated by Peer Group  
 In Accordance With P.A. 845  
 Chairman Dale Kesler

Register of Deeds Stamp & File Number

**SECTION**

For corners in <u>CASS</u> (County)	Located In:	Corner Code #
1. Public Land Survey LAGRANGE TWP.	<u>T 6S R 15W</u>	<u>H-13</u>
	T _____ R _____	_____
	T _____ R _____	_____
	T _____ R _____	_____
2. Property Controlling in Section	S _____ T _____ R _____	_____
	S _____ T _____ R _____	_____
3. Miscellaneous Property in Sec.	S _____ T _____ R _____	_____
	S _____ T _____ R _____	_____

4. Lot No. \_\_\_\_\_, Recorded Plat \_\_\_\_\_  
 5. Private Claims \_\_\_\_\_

	A	B	C	D	E	F	G	H	I	J	K	L	M
1													
2	6		5		4		3		2		1		
3													
4	7		8		9		10		11		12		
5													
6	18		17		16		15		14		13		
7													
8	19		20		21		22		23		24		
9													
10	30		29		28		27		26		25		
11													
12	31		32		33		34		35		36		
13													


I, DALE L. KESLER, in a field survey on AUG 13, 1997 do hereby state that under requirements of P.A. 74, Michigan P.A. of 1970, the corner points mentioned in lines 1 and 2 above were in conformance with regulations and rules therefore as required in the current manual of survey instructions of the United States Department of the Interior, Bureau of Land Management or by a decree of a Court of Law and /or that the corner points mentioned in lines 3, 4 and 5 above were in conformance with the rules of the Michigan Board of Land Surveyors or by a Decree of a Court of Law; established, re-established, monumented, recovered, found as expressed below:

**NOTE: Not more than 2 corners, all in the same town and range, may be recorded on this certificate.**

A. Description of original monument and accessories and/or subsequent restoration:  
 \*1827 SURVEY BY WILLIAM BROOKFIELD. WEST 40.00 CH. SET QUARTER POST. 16" OAK N 74 3/4 E 1.32, 10" OAK N 25 1/2 W 2.40.  
 \*MAR. 16-19, 1916 SURVEY BY W.W. REYNOLDS, COUNTY SURVEYOR. ESTABLISHED ON TRUE LINE BETWEEN SECTION CORNERS AND AT 358 LKS. E OF JEFFERSON CORNER. PLACED STONE. WITNESSES: ELM 36" S 51 1/2 DEGREES W 54 2/3 LKS., MAPLE 20" S 50 DEGREES E 54 LKS.  
 \*JUNE 20, 1986 SURVEY BY WIGHTMAN-PEIRCE, INC. ESTABLISHED THE SOUTH LINE OF SECTION 34 FROM THE NORTHWEST CORNER OF SECTION 3 WITH THE SOUTH QUARTER CORNER OF SECTION 34.

B. Description of corner evidence found and/or method applied in restoring or reestablishing corner:  
 NO MONUMENT WAS FOUND AT THIS CORNER. REESTABLISHED THE CORNER AT THE MIDWAY POINT AND ON LINE BETWEEN THE SW CORNER OF SECTION 34, T6S, R15W, AND THE SE CORNER OF SECTION 34, T6S, R15W.

C. Description of monument for corner and accessories established to perpetuate locating the position of the corner:  
 SET 3/4" IRON PIPE WITH ALUMINUM CAP IN A MONUMENT BOX AND IS ACCEPTED AS A CAREFUL AND FAITHFUL REESTABLISHMENT OF THE POSITION OF THE ORIGINAL CORNER.  
 PK NAIL IN POWER POLE N 76 DEGREES 54' E 254.85'  
 3/4" IRON PIPE CAPPED N 27 DEGREES 10' W 63.50'  
 PK NAIL IN POWER POLE N 38 DEGREES 04' W 78.25'  
 PK NAIL IN 30" OAK S 80 DEGREES 58' E 208.68'  
 N 1/4 COR., SECTION 3, T7S, R15W, WEST 236.28'

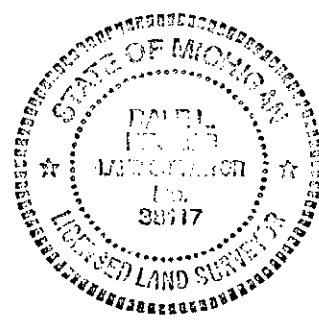

Signed by Dale Kesler Date 12/24/97  
 Surveyor's Michigan License No. 38117