

SURVEY & REMONUMENTATION

FEB 19 1998

Liber 00003 Page 0124

SECTION

LAND CORNER RECORDATION CERTIFICATE
Filing Requirement of Act 74, Mich. P.A. 1970
CASS COUNTY REMONUMENTATION

STATE OF MICHIGAN
 COUNTY OF CASS
 Recorded

For corners in <u>CASS</u> (County)	Located In:	Corner Code #
1. Public Land Survey LAGRANGE TWP.	<u>T 6S R 15W</u>	<u>I-13</u>
	T ___ R ___	_____
	T ___ R ___	_____
	T ___ R ___	_____
2. Property Controlling in Section	S ___ T ___ R ___	_____
	S ___ T ___ R ___	_____
3. Miscellaneous Property in Sec.	S ___ T ___ R ___	_____
	S ___ T ___ R ___	_____

12-26-1997 11:55:01

Ann L. Simmons
 REGISTER OF DEEDS

Registered in Accordance with P.A. 345
 Chairman Dale Kesler

Register of Deeds Stamp & File Number

4. Lot No. _____, Recorded Plat _____
 5. Private Claims _____

I, DALE L. KESLER, in a field survey on AUG. 13, 1997 do hereby state that under requirements of P.A. 74, Michigan P.A. of 1970, the corner points mentioned in lines 1 and 2 above were in conformance with regulations and rules therefore as required in the current manual of survey instructions of the United States Department of the Interior, Bureau of Land Management or by a decree of a Court of Law and for that the corner points mentioned in lines 3, 4 and 5 above were in conformance with the rules of the Michigan Board of Land Surveyors or by a Decree of a Court of Law; established, re-established, monumented, recovered, found as expressed below:

	A	B	C	D	E	F	G	H	I	J	K	L	M
1													
2	6		5		4		3		2		1		
3													
4	7		8		9		10		11		12		
5													
6	18		17		16		15		14		13		
7													
8	19		20		21		22		23		24		
9													
10	30		29		28		27		26		25		
11													
12	31		32		33		34		35		36		
13													

NOTE: Not more than 2 corners, all in the same town and range, may be recorded on this certificate.

A. Description of original monument and accessories and/or subsequent restoration:


- * 1827 WILLIAM BROOKFIELD - WEST 80.00 CH. SET POST, OAK N 89 1/2 E 3.66 CH., 8" HICKORY N 88 3/4 W 3.63.
- * MAR. 16-19, 1916 SURVEY BY W.W. REYNOLDS, COUNTY SURVEYOR, ESTABLISHED LINE BETWEEN SW CORNER SECTION 34, AND SE CORNER SECTION 35 AND ON NORTH AND SOUTH LINE AGREEING NORTH FENCE I HAVE KNOWN 50 YEARS. WITNESSES: ELM 30" S 69 1/2 DEGREES E 154 1/2 LKS.
- * JUNE 1990 WIGHTMAN-PEIRCE, INC. FOUND R.R. SPIKE. WITNESSES: 4" TRIPLE ELM SOUTH 40.40', 12" ELM S 40 DEGREES E 60.50', 4" ELM S 3 DEGREES W 41.0'.

B. Description of corner evidence found and/or method applied in restoring or reestablishing corner:

FOUND R.R. SPIKE IN HIGHWAY. THE ACCESSORIES OF THE 1990 SURVEY BY WIGHTMAN-PEIRCE, INC. VERIFY LOCATION OF CORNER. DISTANCES TO ADJACENT CORNERS WERE REASONABLE AND CONSISTENT. ACCEPTED R.R. SPIKE AS BEST EVIDENCE OF CORNER.

C. Description of monument for corner and accessories established to perpetuate locating the position of the corner:

- SET 3/4" IRON PIPE WITH ALUMINUM CAP IN PLACE OF R.R. SPIKE IN A MONUMENT BOX AND IS ACCEPTED AS THE BEST AVAILABLE EVIDENCE OF THE POSITION OF THE ORIGINAL CORNER.
- PK NAIL IN POWER POLE N 60 DEGREES 14' W 178.40'
- PK NAIL IN POWER POLE N 56 DEGREES 41' E 163.15'
- 1/2" CAPPED BAR NORTH 50.00'
- PK NAIL 18" ELM S 39 DEGREES 49' E 60.55'
- NE COR. SECTION 3, T7S, R15W, WEST 262.68'

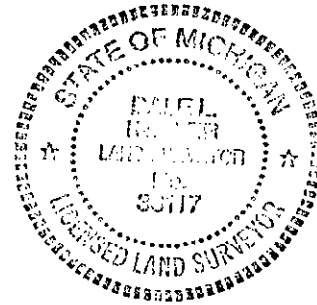

Signed by Dale Kesler
 Surveyor's Michigan License No. 38117

Date 12/24/97