

JAN 21 1999

SECTION

**CASS COUNTY REMONUMENTATION
LAND CORNER RECORDATION CERTIFICATE
Filing Requirement of Act 74, Mich. P.A. 1970**

For corners in **CASS COUNTY** Located in: **POKAGON TWP.** Corner Code # **(A-2) W1/4 Cor Sec 6 T6S,R16W**

- | | | | |
|------------------------------------|-------------|--------------|------------|
| 1. Public Land Survey | T <u>6S</u> | R <u>16W</u> | <u>A-2</u> |
| | T _____ | R _____ | _____ |
| | T _____ | R _____ | _____ |
| | T _____ | R _____ | _____ |
| 2. Property Controlling in Section | S _____ | T _____ | R _____ |
| | S _____ | T _____ | R _____ |
| 3. Miscellaneous Property in Sec. | S _____ | T _____ | R _____ |
| | S _____ | T _____ | R _____ |
4. Lot No _____, Recorded Plat _____
5. Private Claims _____

STATE OF MICHIGAN
COUNTY OF CASS
Recorded
12-22-1998 15:36:37
Ann L. Simmons
REGISTER OF DEEDS
Register of Deeds Stamp & File Number

In Accordance With Act 74, 1970
 Date Oct 79, 1998

I, Alan Bartlett in a field survey on November 16, 1998 hereby certify that under requirements of P.A. 74, Michigan P.A. of 1970, the corner points mentioned in lines 1 and 2 above were in conformance with regulations and rules therefore as required in the current manual of survey instructions of the United States Department of the Interior, Bureau of Land Management or by a decree of a Court of Law and/or that the corner points mentioned in lines 3, 4 and 5 above were in conformance with the rules of the Michigan Board of Land Surveyors or by a Decree of a Court of Law; established, re-established, monumented, re-monumented, recovered, found as expressed below:

	A	B	C	D	E	F	G	H	I	J	K	L	M
2	8		5		4		3		2		1		
3													
4	7		8		9		10		11		12		
5													
6	18		17		16		15		14		13		
7													
8	19		20		21		22		23		24		
9													
10	30		29		28		27		26		25		
11													
12	31		32		33		34		35		36		
13													

NOTE: Not more than 4 corners, all in the same town and range, may be recorded on this certificate.

A. Description of original monument and accessories and/or subsequent restoration:

(NOT SET IN ORIGINAL GOVERNMENT SURVEY)

(PLEASE SEE BACK PAGE)

Liber **00003** Page **0180**

B. Description of corner evidence found and/or method applied in restoring or reestablishing corner:

Corner not set in original government survey. This corner set using pro rate of GLO closing to North township line. This corner position approved by Cass County Remonumentation Peer Group of Surveyors on October 29, 1998.


C. Description of monument for corner and accessories established to perpetuate locating the position of the corner:

Set Cass County Remonumentation Cap and Galvanized Pipe in Monument Box 3' West of Center Line Brush Lake Road.

Witnesses		
S55E	Fnd nail S.W. Side of P.P.	29.02'
S30W	Set nail and flasher in NW side 24" Maple	49.65'
S80W	Fnd Nail in N side P.P.	58.37'
N20W	CL top of Phone Riser	61.31'
N00E	E1/4 SEC. 1-5-17 M-2	10.88'
S00E	Iron Bar previously used as W1/4	14.17'

This position not established by original government survey. This monument is accepted as the best available evidence of the position of the corner.

Signed by Alan K. Bartlett Date 12/16/98
Surveyor's Michigan License No. 35988

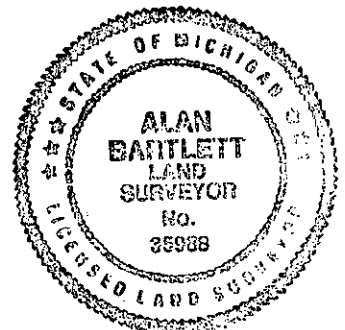

**SURVEY &
REMONUMENTATION**

JAN 21 1999

SECTION

A-2 W 1/4 CORNER SECTION 6 SILVER CREEK TWP. T6S, R16W

8/1973 Robert Prestine (misc notes)

W 1/4 Cor. Sec 6

1/2" Copperweld Rod in Mon. Box.

Witnesses

10" Oak S32W 37.34'

14" Oak S85E 42.37'

20" Oak N25E 77.34'

Fe to East North 11.00'

Jog = 25.1' Liber 959 Page 94

Dec 1972 H. Donald Peirce RLS#3311 Recorded survey(Liber1 Page 342)

found 1/2" Bar in Mon Box

Witnesses

PP S85E 22.82'

6" Oak S40W 37.40'

Oct 1973 N.C. Jones LCRC Liber1 Page 275

Set 1/2" Copperweld Rod in Mon Box LCRC L1 P275

Witnesses

same as Prestine Misc Notes

1998 Landmark Technologies Alan Bartlett RLS#35988

Found 1/2" copper weld in Monument Box 3' West Center Line Brush Lake Road

Witnesses

S20W N & F in Nw Side 24" Maple 66.33'

S40W N & F in NW Side 24" Maple 37.50'

N20W CL top of phone riser 74.17'

S15E Fnd Nail in SW side of P.P. 22.53'

North 25.06' to Iron Pipe

Liber 00003 Page 0181