

REMONUMENTATION COMMISSION
 APR 06 1995
 or corners

STATE OF MICHIGAN
 CASS COUNTY
 RECEIVED FOR RECORD

LAND CORNER RECORDATION CERTIFICATE
 Filing Requirement of Act 74, Mich. P.A. 1970

1994 DEC 28 PM 1 48

CASS (County) Located In: Corner Code #
 Public Land Survey T 6 S R 16 W A-9
 T R
 T R
 T R
 Property Controlling S T R
 in Section S T R
 Miscellaneous S T R
 Property in Sec. S T R

Ann L. Simmons
 CLERK/REGISTER

LIBER 2 PAGE 381

Register of Deeds Stamp & File Number

Validated by Peer Group
 In Accordance With P.A. 345
 Chairman *Sal C. Kelly*
 Date *Dec 22, 1994*

Lot No. _____, Recorded Plat _____
 Private Claims _____

	A	B	C	D	E	F	G	H	I	J	K	L	M
2	6		5		4		3		2		1		
3													
4	7		8		9		10		11		12		
5													
6	18		17		16		15		14		13		
7													
8	19		20		21		22		23		24		
9													
10	30		29		28		27		26		25		
11													
12	31		32		33		34		35		36		
13													

Robert W. Prestine, in a field survey on June 27, 1994
 hereby certify that under requirements of P.A. 74, Michigan P.A. of 1970, the corner points mentioned in lines 1 and 2 above were in conformance with regulations and rules therefore as required in the current manual of survey instructions of the United States Department of the Interior, Bureau of Land Management or by a decree of a Court of Law and/or that the corner points mentioned in lines 3, 4 and 5 above were in conformance with the rules of the Michigan Board of Land Surveyors or by a Decree of a Court of Law; established, re-established, monumented, re-monumented, recovered, found as expressed below:

NOTE: Not more than 4 corners, all in the same town and range, may be recorded on this certificate.

Description of original monument and accessories and/or subsequent restoration:


A-9 Northwest corner Section 30, T. 6 S., R. 16 W
 Govt.
 Set post, Wm. Brookfield 1828
 Maple 9" N 81° E 14 links
 Maple 8" S 23° E 33 links

Description of corner evidence found and/or method applied in restoring or reestablishing corner:

Originally found stone, September 21, 1990 (by self) 36" deep
 Set iron over.
 17.16' South of Berrien County corner

Description of monument for corner and accessories established to perpetuate locating the position of the corner:

Removed iron & set Cass County remonumentation monument over stone
 Nail & witness tag in 5" Oak S 42° W 26.75'
 Nail & witness tag in East side North limb of 18" Twin Basswood South 37.21'
 Nail & witness tag in North side 23" Maple S 74° W 54.05'
 Berrien County corner is North 17.16 feet
 1" iron in center line of road North 22.16 feet
 11.8" South of South edge of Asphalt

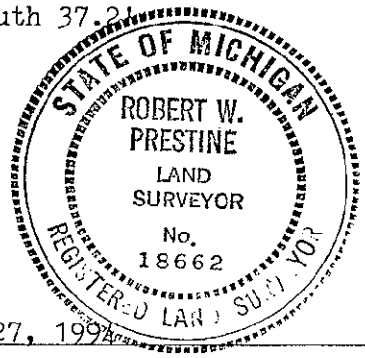

Signed by *Robert W. Prestine*

Date December 27, 1994

Surveyor's Michigan License No. 18662