

LAND SURVEY &
 REMONUMENTATION
 APR 06 1995
 COMMISSION

STATE OF MICHIGAN
 CASS COUNTY
 RECEIVED FOR RECORD

LAND CORNER RECORDATION CERTIFICATE

Filing Requirement of Act 74, Mich. P.A. 1970

CASS COUNTY REMONUMENTATION 1994 DEC 28 PM 1 44

CASS (County)	Located In:	Corner Code #/
Public Land Survey	T 6 S R 16 W	C-13
	T ___ R ___	_____
	T ___ R ___	_____
	T ___ R ___	_____
Property Controlling in Section	S ___ T ___ R ___	_____
	S ___ T ___ R ___	_____
Miscellaneous Property in Sec.	S ___ T ___ R ___	_____
	S ___ T ___ R ___	_____

Ann M. Simmons
 CLERK/REGISTER

LIBER 2 PAGE 368

Register of Deeds Stamp & File Number

Ratified by Peer Group
 In Accordance With P.A. 345
 Chairman Dale C. Keeler
 Date Dec. 22, 1993

Lot No. _____, Recorded Plat _____
 Private Claims _____

	A	B	C	D	E	F	G	H	I	J	K	L	M
2	6	5	4	3	2	1							
3													
4	7	8	9	10	11	12							
5													
6	18	17	16	15	14	13							
7													
8	19	20	21	22	23	24							
9													
10	30	29	28	27	26	25							
11													
12	31	32	33	34	35	36							
13													


Robert W. Prestine in a field survey on December 8 - 93
September 2, 1994
 hereby certify that under requirements of P.A. 74, Michigan P.A. of 1970, the corner points mentioned
 lines 1 and 2 above were in conformance with regulations and rules therefore as required in the
 current manual of survey instructions of the United States Department of the Interior, Bureau of Land
 management or by a decree of a Court of Law and/or that the corner points mentioned in lines 3, 4 and 5
 above were in conformance with the rules of the Michigan Board of Land Surveyors or by a Decree of a
 Court of Law; established, re-established, monumented, re-monumented, recovered, found as
 expressed below:

NOTE: Not more than 4 corners, all in the same town and range, may be recorded on this certificate.

Description of original monument and accessories and/or subsequent restoration:
 C-13 Southwest corner Section 32, T. 6 S., R. 16 W
 Govt.
 Set Post, Wm. Brookfield, January 13, 1827
 Sycamore 30" N 53½° E 39 links
 Elm 15" N 76° W 16 links

Description of corner evidence found and/or method applied in restoring or reestablishing corner:
 Found ½" pipe set by self November 1973
 Indiana & Michigan Electric Co. survey of April 30, 1931 shows corner unmarked.
 No witness
 Jog of 149.16' West of Northwest corner Section 5, T. 7 S., R. 16 W. (2.26 chains)

Description of monument for corner and accessories established to perpetuate locating the position of the corner:
 Removed iron & set Cass County remonumentation monument with stones around
 Nail & witness tag on West side 5" Wild Cherry S 38° E 14.90'
 Nail & witness tag on East side 6" Hackberry N 22° W 8.05'
 Nail & witness tag on North side 30" Wild Cherry West 37.05'
 Howard Township corner East 149.16' (Monument)

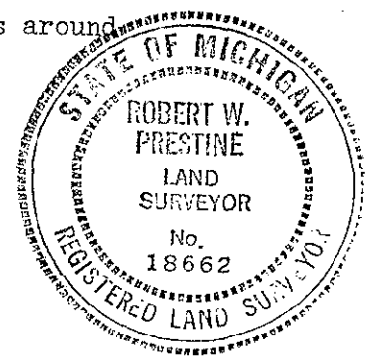

Red by Robert W. Prestine Date December 27, 1994
 Surveyor's Michigan License No. 18662