

REMONUMENTATION
 APR 06 1995
 COMMISSION

STATE OF MICHIGAN
 CASS COUNTY
 RECEIVED FOR RECORD

LAND CORNER RECORDATION CERTIFICATE

Filing Requirement of Act 74, Mich. P.A. 1970

CASS COUNTY REMONUMENTATION

1994 DEC 28 PM 1 47

Corners in
 CASS (County)
 Located In: Corner Code #
 Public Land Survey T 6 S R 16 W F-13
 T R
 T R
 T R
 Property Controlling S T R
 in Section S T R
 Miscellaneous S T R
 Property in Sec. S T R

Ann L. Simmons
 CLERK/REGISTER

LIBER 2 PAGE 374

Register of Deeds Stamp & File Number

Validated by Peer Group
 In Accordance With P.A. 345
 Chairman *Dee L. Keeler*
 Date *Dec 27 1993*

Lot No. _____, Recorded Plat _____
 Private Claims _____

December 21 - 93

Robert W. Prestine, in a field survey on December 20, 1994,
 hereby certify that under requirements of P.A. 74, Michigan P.A. of 1970, the corner points mentioned
 in lines 1 and 2 above were in conformance with regulations and rules therefore as required in the
 current manual of survey instructions of the United States Department of the Interior, Bureau of Land
 Management or by a decree of a Court of Law and/or that the corner points mentioned in lines 3, 4 and 5
 above were in conformance with the rules of the Michigan Board of Land Surveyors or by a Decree of a
 Court of Law; established, re-established, monumented, re-monumented, recovered, found as
 expressed below:

	A	B	C	D	E	F	G	H	I	J	K	L	M
2	6	5	4	3	2	1							
3													
4	7	8	9	10	11	12							
5													
6	18	17	16	15	14	13							
7													
8	19	20	21	22	23	24							
9													
10	30	29	28	27	26	25							
11													
12	31	32	33	34	35	36							
13													

NOTE: Not more than 4 corners, all in the same town and range, may be recorded on this certificate.

Description of original monument and accessories and/or subsequent restoration:


F-13 South quarter corner Section 33, T. 6 S., R. 16 W.
 Govt.
 Set post, Wm. Brookfield 1827
 White Oak 7" N 75 2/3° E 52 links
 Yellow Oak 9" N 72° W 77 links

Description of corner evidence found and/or method applied in restoring or reestablishing corner:

Found 3/4" iron pipe
 H.L. Dreher 1958 iron set 86.46' West of North quarter corner Section 4, T. 7 S., R. 16 W.
 R.W. Prestine Dec. 8, 1993 3/4" iron in open field 12" deep 86.46' West of
 North quarter corner Section 4, T 7 S., R. 16 W.

Description of monument for corner and accessories established to perpetuate locating the position of the corner:

Removed iron & set Cass County remonumentation monument 12" deep in open field
 Nail & witness tag in Southwest side 37" White Oak N 46° W 40.12'
 Nail & witness tag in West side Electric pole N 13° W 98.38'
 Nail & witness tag in South side 12" White Oak N 59° E 91.35'
 Center line of road East 50' ±
 86.46' West of North quarter corner Section 4, T 7 S., R. 16 W.,

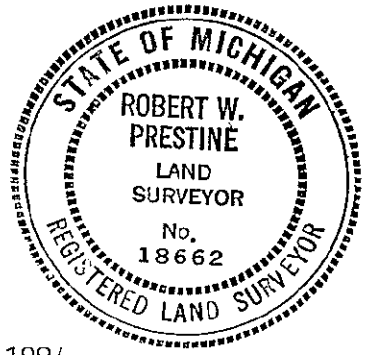

Witnessed by *Robert W. Prestine* Date December 27, 1994
 Surveyor's Michigan License No. 18662