

LAND CORNER RECORDATION CERTIFICATE
Filing Requirement of Act 74, Mich. P.A. 1970

For corners in

Cass (County)	Located In:	Corner Code //
1. Public Land Survey	T 7S R 13W	M-7, M-6
	T R	
	T R	
	T R	
2. Property Controlling in Section	S T R	
	S T R	
3. Miscellaneous Property in Sec.	S T R	
	S T R	
4. Lot No. _____, Recorded Plat _____		
5. Private Claims _____		

Register of Deeds Stamp & File Number

I, Donald L. Bissell, in a field survey on October, 19 89, do hereby certify that under requirements of P.A. 74, Michigan P.A. of 1970, the corner points mentioned in lines 1 and 2 above were in conformance with regulations and rules therefore as required in the current manual of survey instructions of the United States Department of the Interior, Bureau of Land Management or by a decree of a Court of Law and/or that the corner points mentioned in lines 3, 4 and 5 above were in conformance with the rules of the Michigan Board of Land Surveyors or by a Decree of a Court of Law, established, re-established, monumented, re-monumented, recovered, found as expressed below:

NOTE: Not more than 4 corners, all in the same town and range, may be recorded on this certificate.

	A	B	C	D	E	F	G	H	I	J	K	L	M
2	6	5	4	3	2	1							
3													
4	7	8	9	10	11	12							
5													
6	18	17	16	15	14	13							
7													
8	19	20	21	22	23	24							
9													
10	30	29	28	27	26	25							
11													
12	31	32	33	34	35	36							
13													

A. Description of original monument and accessories and/or subsequent restoration:

B. Description of corner evidence found and/or method applied in restoring or reestablishing corner:

M-7 SE Cor. Sec. 13
 Found 1/2" Rod

M-6 E 1/4 Cor. Sec. 13
 Found 4" Conc. Mon.


C. Description of monument for corner and accessories established to perpetuate locating the position of the corner:

M-7 SE Cor. Sec. 13
 1/2" Rod
 N 51°E - 39.65' - Triple 8" R. Oak
 S 70°E - 33.62' - 8" Maple
 S 32°E - 46.67' - 7" Cherry
 East - 3' - Center Road
 Spike / Tag + Blaze in Trees

M-6 E 1/4 Cor. Sec. 13
 4" Conc. Mon.
 S 47°E - 32.76' - 7" Maple
 S 64°W - 14.48' - 9" Maple
 N 63°W - 18.25' - 10" Maple
 N 12°W - 9.13' - 16" Hickory
 South - 94.89' - Conc. Mon. w/Alum. Cap
 W 1/4 Cor. Sec. 18, T7S, R12W

Signed by Donald L. Bissell

Date

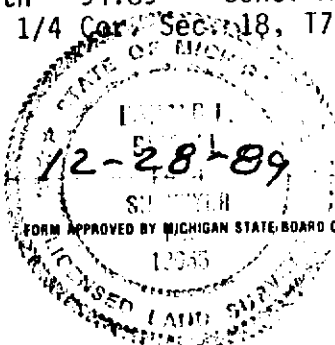

Surveyor's Michigan License No. 18655

FORM APPROVED BY MICHIGAN STATE BOARD OF LAND SURVEYORS, JAN 28, 1971
 REVISED MAY 14, 1975
 REVISED JAN., 1983