

Referred by Firm Group
 Account No. 111, 018
 Chairman Dale Kesler
 Date December 20, 1995

LAND CORNER RECORDATION CERTIFICATE
Filing Requirement of Act 74, Mich. P.A. 1970
CASS COUNTY REMONUMENTATION

STATE OF MICHIGAN
 COUNTY OF CASS
 Recorded
 12-28-1995 16:07:52
 Ann L. Simmons
 REGISTER OF DEEDS

For corners in CASS (County) Located In: Corner Code #

1. Public Land Survey	T <u>7</u>	R <u>13</u>	<u>M-1</u>
NORTH PORTER TWP.	T	R	
	T	R	
	T	R	
	T	R	
2. Property Controlling in Section	S	T	R
	S	T	R
3. Miscellaneous Property in Sec.	S	T	R
	S	T	R

4. Lot No. _____, Recorded Plat _____
 5. Private Claims _____

Register of Deeds Stamp & File Number

DALE L. KESLER in a field survey on NOVEMBER 28, 19 95
 do hereby certify that under requirements of P.A. 74, Michigan P.A. of 1970, the corner points mentioned in lines 1 and 2 above were in conformance with regulations and rules therefore as required in the current manual of survey instructions of the United States Department of the Interior, Bureau of Land Management or by a decree of a Court of Law and/or that the corner points mentioned in lines 3, 4 and 5 above were in conformance with the rules of the Michigan Board of Land Surveyors or by a Decree of a Court of Law; established, re-established, monumented, re-monumented, recovered, found as expressed below:

	A	B	C	D	E	F	G	H	I	J	K	L	M
2	6	5	4	3	2	1							
3													
4	7	8	9	10	11	12							
5													
6	18	17	16	15	14	13							
7													
8	19	20	21	22	23	24							
9													
10	30	29	28	27	26	25							
11													
12	31	32	33	34	35	36							
13													

NOTE: Not more than 4 corners, all in the same town and range, may be recorded on this certificate.

Description of original monument and accessories and/or subsequent restoration:

Dec. 26, 1826 - William Brookfield - Set post - Set by going North on east line Section 1 from East Quarter post 40 Chains (2640'). Set temporary 6 mi. post. West on the South boundary of Section 31, T6S, R12W, 79.35 Chains, intersected Range line 3.30 links North of the temporary 6 mi. post. Set post at intersection corner of Township 6 & 7 South, Ranges 12 & 13 West.
 6" White Oak tree - N. 12° E. 7' Links
 6" White Oak tree - N. 47 1/2° W. 158 Links
 (Over)


Description of corner evidence found and/or method applied in restoring or reestablishing corner:

Found bolt spike next to 1" capped pipe. Accepted 1" capped pipe as best evidence of corner.

MAR 27 1996
 COMMISSION

Description of monument for corner and accessories established to perpetuate locating the position of the corner:

Set 3/4" X 24" iron pipe with aluminum cap in place of 1" capped pipe in monument box and is accepted as a careful and faithful perpetuation of the position of the original corner.
 Nut on riser N. 57° 30' W. - 56.00'
 Nail w/washer in SE side 45" Oak - S. 68° 30' W. 76.15'
 NE Corner Building - S. 43° W. 76.22'
 PK in North side 14" Oak - S. 73° 30' E. 132.45'
 PK in Southeast side Pole - N. 38° E. 48.63'

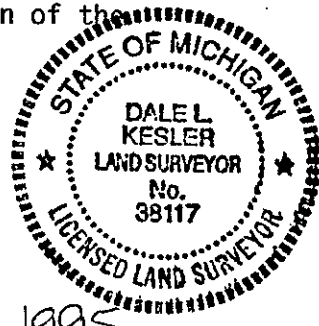

Signed by Dale Kesler Date December 28, 1995
 Surveyor's Michigan License No. No. 38117

A. Continued -

July 1, 1975 - Vernon Hendershot - Found bolt spike next to 1" capped pipe - Recorded in Liber 1, Page 436, witnesses - 1" capped iron -
Nut on riser N. $57^{\circ} 30'$ W. 56.00'
PK Nail in SE side 45" Oak tree - S. $68^{\circ} 30'$ W. 76.15'
NE Corner Building - S. 43° W. 76.22'
PK Nail in N. side 14" Oak tree - S. $73^{\circ} 30'$ E. 132.45'
PK Nail in SE side pole - N. 38° E. 48.63'

Apr. 7, 1989 - Wightman-Peirce, Inc. - Found bolt in box - no witnesses.