

**SURVEY &
REMONUMENTATION**

APR 26 1995

COMMISSION

STATE OF MICHIGAN
CASS COUNTY
RECEIVED FOR RECORD

LAND CORNER RECORDATION CERTIFICATE

Filing Requirement of Act 74, Mich. P.A. 1970

1994 NOV 8 PM 2 54

CASS COUNTY REMONUMENTATION

For corners in

<u>CASS</u> (County)	Located In:	Corner Code #
1. Public Land Survey	T <u>7</u> R <u>14</u>	<u>D-1</u>
	T _____ R _____	_____
	T _____ R _____	_____
	T _____ R _____	_____
2. Property Controlling in Section	S _____ T _____ R _____	_____
	S _____ T _____ R _____	_____
3. Miscellaneous Property in Sec.	S _____ T _____ R _____	_____
	S _____ T _____ R _____	_____

Anna L. Dimmons
CLERK/REGISTER

LICER 2 PAGE 362

Register of Deeds Stamp & File Number

Platified by Peer Group
In Accordance With P.A. 845
Chairman *[Signature]*

4. Lot No. _____, Recorded Plat _____
5. Private Claims _____

	A	B	C	D	E	F	G	H	I	J	K	L	M
2	6		5		4		3		2		1		
3													
4	7		8		9		10		11		12		
5													
6	18		17		16		15		14		13		
7													
8	19		20		21		22		23		24		
9													
10	30		29		28		27		26		25		
11													
12	31		32		33		34		35		36		
13													

I, Dale L. Kesler, in a field survey on October 6, 19 94, do hereby certify that under requirements of P.A. 74, Michigan P.A. of 1970, the corner points mentioned in lines 1 and 2 above were in conformance with regulations and rules therefore as required in the current manual of survey instructions of the United States Department of the Interior, Bureau of Land Management or by a decree of a Court of Law and/or that the corner points mentioned in lines 3, 4 and 5 above were in conformance with the rules of the Michigan Board of Land Surveyors or by a Decree of a Court of Law, established, re-established, monumented, re-monumented, recovered, found as expressed below:

NOTE: Not more than 4 corners, all in the same town and range, may be recorded on this certificate.

A. Description of original monument and accessories and/or subsequent restoration:

1965 - H. D. Peirce did not find or set corner, used the south quarter corner of Section 32, T. 6 S., R. 14 W., East 7.59'.


B. Description of corner evidence found and/or method applied in restoring or reestablishing corner:

Found nothing at corner, set corner 7.59' west of the south quarter corner of Section 32, T 6 S, R 14 W and on line between the south quarter corner of Section 32, T 6 S, R 14 W and the southwest corner of said Section 32, T 6 S, R 14 W.

C. Description of monument for corner and accessories established to perpetuate locating the position of the corner:

Set standard 2' iron pipe w/aluminum cap. This position not established by original government surveyors. This monument is accepted as the best available evidence of the position of the corner.

South quarter corner, Section 32, T 6 S, R 14 W, East 7.59'
Set PK nail w/washer in 54" Elm (Southside) N. 60° E. 1.27'
Set PK nail w/washer in 32" Elm (Southside) N. 85° W. 8.36'
Set PK nail w/washer in 24" Elm - N. 19° W. 33.42'

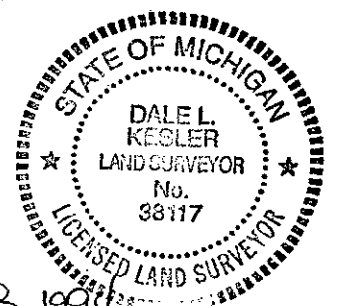

Signed by *Dale Kesler* Date November 8, 1994
Surveyor's Michigan License No. #38117