

**SURVEY & REMONUMENTATION**

APR 26 1995

**COMMISSION**

**LAND CORNER RECORDATION CERTIFICATE**

Filing Requirement of Act 74, Mich. P.A. 1970  
CASS COUNTY REMONUMENTATION

STATE OF MICHIGAN  
CASS COUNTY  
RECEIVED FOR RECORD

1994 NOV 8 PM 2 53

For corners in

CASS  
(County)

Located In:

Corner Code #

- |                                    |   |   |   |    |     |
|------------------------------------|---|---|---|----|-----|
| 1. Public Land Survey              | T | 7 | R | 14 | E-1 |
|                                    | T |   | R |    |     |
|                                    | T |   | R |    |     |
|                                    | T |   | R |    |     |
| 2. Property Controlling in Section | S |   | T | R  |     |
|                                    | S |   | T | R  |     |
| 3. Miscellaneous Property in Sec.  | S |   | T | R  |     |
|                                    | S |   | T | R  |     |

*Ann L. Simmons*  
CLERK/REGISTER

LICER 2 PAGE 357

Register of Deeds Stamp & File Number

Ratified by Peer Group  
 In Accordance With P.A. 345  
 Chairman *Dale Kesler*

4. Lot No. \_\_\_\_\_, Recorded Plat \_\_\_\_\_  
 5. Private Claims \_\_\_\_\_

	A	B	C	D	E	F	G	H	I	J	K	L	M
2	6		5		4		3		2		1		
3													
4	7		8		9		10		11		12		
5													
6	18		17		16		15		14		13		
7													
8	19		20		21		22		23		24		
9													
10	30		29		28		27		26		25		
11													
12	31		32		33		34		35		36		
13													

I, Dale L. Kesler, in a field survey on October 6, 1994  
do hereby certify that under requirements of P.A. 74, Michigan P.A. of 1970, the corner points mentioned in lines 1 and 2 above were in conformance with regulations and rules therefore as required in the current manual of survey instructions of the United States Department of the Interior, Bureau of Land Management or by a decree of a Court of Law and/or that the corner points mentioned in lines 3, 4 and 5 above were in conformance with the rules of the Michigan Board of Land Surveyors or by a Decree of a Court of Law; established, re-established, monumented, re-monumented, recovered, found as expressed below:

**NOTE: Not more than 4 corners, all in the same town and range, may be recorded on this certificate.**

A. Description of original monument and accessories and/or subsequent restoration:

1828 - Calvin J. Britain set post - 21 Lks. west of post to Sections 4 and 5, accessories 5" Tamarack tree S. 59° W. 38 Lks., 7" Tamarack tree S. 50° E. 25 Lks.;  
 1973 - H. D. Peirce found 3/4" iron pipe 13.86' west of southeast corner of Section 32, T. 6 S., R. 14 W.


B. Description of corner evidence found and/or method applied in restoring or reestablishing corner:

Found 3/4" iron pipe, distance to adjacent corners were reasonable and consistent. Accepted standard monument as best evidence of corner.

C. Description of monument for corner and accessories established to perpetuate locating the position of the corner:

Set standard 2' iron pipe w/aluminum cap in monument box and accepted as a careful and faithful perpetuation of the position of the original corner.

Centerline of road West 8.80'  
 East end 12" CMP S. 53° 28' E. 35.10'  
 Set PK nail w/washer, 14" Cluster of 3 Sycamores S. 10° 17' W. 84.80'  
 Southeast corner Section 32, T. 6 S., R. 14 W. East 13.86'

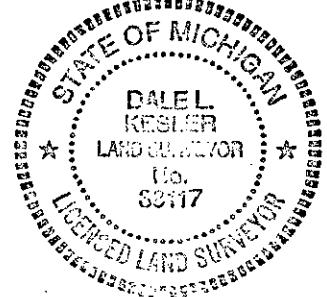

Signed by *Dale L. Kesler*

Date November 8, 1994

Surveyor's Michigan License No. No. 38117