

LAND CORNER RECORDATION CERTIFICATE
Filing Requirement of Act 74, Mich. P.A. 1970

1994 NOV 8 PM 2 54

For corners in

CASS
(County)

Located In:

Corner Code #

- | | | | | | |
|------------------------------------|---|----------|---|-----------|------------|
| 1. Public Land Survey | T | <u>7</u> | R | <u>14</u> | <u>F-1</u> |
| | T | _____ | R | _____ | _____ |
| | T | _____ | R | _____ | _____ |
| | T | _____ | R | _____ | _____ |
| 2. Property Controlling in Section | S | _____ | T | _____ | _____ |
| | S | _____ | T | _____ | _____ |
| 3. Miscellaneous Property in Sec. | S | _____ | T | _____ | _____ |
| | S | _____ | T | _____ | _____ |

Ann L. Dimmond
CLERK/REGISTER

LIBR 2 PAGE 363

Register of Deeds Stamp & File Number

Ratified by Peer Group
In Accordance With P.A. 245
Chairman *Dale Kesler*
Date *September 22, 1994*

4. Lot No. _____, Recorded Plat _____
5. Private Claims _____

	A	B	C	D	E	F	G	H	I	J	K	L	M
2	6	5	4	3	2	1							
3													
4	7	8	9	10	11	12							
5													
6	18	17	16	15	14	13							
7													
8	19	20	21	22	23	24							
9													
10	30	29	28	27	26	25							
11													
12	31	32	33	34	35	36							
13													

I, Dale L. Kesler, in a field survey on October 6, 19 94, do hereby certify that under requirements of P.A. 74, Michigan P.A. of 1970, the corner points mentioned in lines 1 and 2 above were in conformance with regulations and rules therefore as required in the current manual of survey instructions of the United States Department of the Interior, Bureau of Land Management or by a decree of a Court of Law and/or that the corner points mentioned in lines 3, 4 and 5 above were in conformance with the rules of the Michigan Board of Land Surveyors or by a Decree of a Court of Law; established, re-established, monumented, re-monumented, recovered, found as expressed below:

NOTE: Not more than 4 corners, all in the same town and range, may be recorded on this certificate.

A. Description of original monument and accessories and/or subsequent restoration:

Government Surveyor did not set this corner - From further research there was evidence that this corner was monumented.


B. Description of corner evidence found and/or method applied in restoring or reestablishing corner:

Found nothing, set corner 0.66 feet west of the south quarter corner of Section 33, T 6 S, R 14 W and on line between the south quarter corner of Section 33, T 6 S, R 14 W and the southeast corner of Section 32, T 6 S, R 14 W.

C. Description of monument for corner and accessories established to perpetuate locating the position of the corner:

Set concrete monument w/aluminum cap (in swamp). This position not established by original government surveyors. This monument is accepted as the best available evidence of the position of the corner.

- So. 1/4 corner, Section 33, T 6 S, R 14 W (monument) East 0.66'
- Set PK nail w/washer, 14" Maple N. 15° W. 26.85'
- Set PK nail w/washer, 14" Maple S. 74° W. 14.88'
- Set PK nail w/washer, 17" Maple S. 65° E. 11.55'

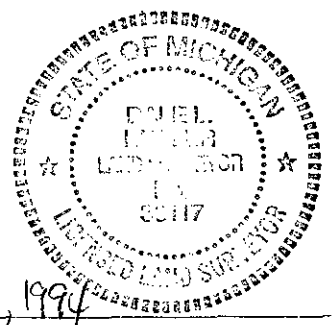

Signed by *Dale Kesler*
Surveyor's Michigan License No. No. 38117

Date November 8, 1994