

Ratified by Peer Group
 In Accordance With P.A. 345
 Chairman Robert W. Prestine
 Date December 20, 1995

Liber 00003 Page 0049

CASS COUNTY REMONUMENTATION
LAND CORNER RECORDATION CERTIFICATE
 Filing Requirement of Act 74, Mich. P.A. 1970

For corners in

CASS (County)	Located In:	Corner Code #
1. Public Land Survey	T <u>7 S</u> R <u>15 W</u>	<u>C-1</u>
	T _____ R _____	_____
	T _____ R _____	_____
	T _____ R _____	_____
2. Property Controlling in Section	S _____ T _____ R _____	_____
	S _____ T _____ R _____	_____
3. Miscellaneous Property in Sec.	S _____ T _____ R _____	_____
	S _____ T _____ R _____	_____
4. Lot No. _____, Recorded Plat _____		
5. Private Claims _____		

STATE OF MICHIGAN
 COUNTY OF CASS
 Recorded
 12-28-1995 16:11:53
 Ann L. Simmons
 REGISTER OF DEEDS

Register of Deeds Stamp & File Number

	A	B	C	D	E	F	G	H	I	J	K	L	M
2	6	5	4	3	2	1							
3													
4	7	6	5	4	3	2	1						
5													
6	15	14	13	12	11	10	9	8	7	6	5	4	3
7													
8	19	18	17	16	15	14	13	12	11	10	9	8	7
9													
10	30	29	28	27	26	25	24	23	22	21	20	19	18
11													
12	31	30	29	28	27	26	25	24	23	22	21	20	19
13													

I, Robert W. Prestine, in a field survey on December 7, 1995, do hereby certify that under requirements of P.A. 74, Michigan P.A. of 1970, the corner points mentioned in lines 1 and 2 above were in conformance with regulations and rules therefore as required in the current manual of survey instructions of the United States Department of the Interior, Bureau of Land Management or by a decree of a Court of Law and/or that the corner points mentioned in lines 3, 4 and 5 above were in conformance with the rules of the Michigan Board of Land Surveyors or by a Decree of a Court of Law; established, re-established, monumented, re-monumented, recovered, found as expressed below:

NOTE: Not more than 4 corners, all in the same town and range, may be recorded on this certificate.

A. Description of original monument and accessories and/or subsequent restoration:

C-1 Northeast corner Section 6, T. 7 S., R. 15 W.
 Govt. wits gone
 Wm. Brookfield D.S. Oct. 1828
 9" Poplar S 36° E 24 links
 8" White Ash S 19° W 14 links


REMONUMENTATION
 MAR 27 1996
 COMMISSION

B. Description of corner evidence found and/or method applied in restoring or reestablishing corner:

C-1
 Found standard Cass County corner.

C. Description of monument for corner and accessories established to perpetuate locating the position of the corner:

C-1 Set 3/4" x 24" iron pipe & Cass County remon cap in monument box.
 50 penny nail & washer in N side Elec. Pole West 53.35'
 N.W. corner conc. fence post S 86° E 25.15'
 S.W. corner Bucher monument in cemetery N 38° W 41.5' Govt jog 234.96'
 Center Dailey Rd. as Cons't West 14.5'± (LaGrange corner is East 234.7'
 This position is accepted as a careful and faithful reestablishment of the position of the original corner.

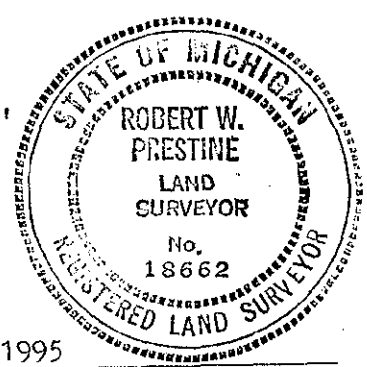

Signed by Robert W. Prestine Date December 28, 1995
 Surveyor's Michigan License No. 18662