

SURVEY & REMONUMENTATION

FEB 19 1998

Liber 00003 Page 0128

SECTION

**LAND CORNER RECORDATION CERTIFICATE
Filing Requirement of Act 74, Mich. P.A. 1970
CASS COUNTY REMONUMENTATION**

For corners in CASS Located In: _____ Corner Code # _____
(County)

1. Public Land Survey T 7S R 15W G-1
JEFFERSON TWP. T _____ R _____
T _____ R _____
T _____ R _____

2. Property Controlling S _____ T _____ R _____
in Section S _____ T _____ R _____

3. Miscellaneous S _____ T _____ R _____
Property in Sec. S _____ T _____ R _____

STATE OF MICHIGAN
COUNTY OF CASS
Recorded
12-26-1997 11:55:54
Ann L. Simmons
REGISTER OF DEEDS

Noted
Date 12/19/97
Chairman Dale L. Kesler
In Accordance With P.A. 945
Relieved by Peer Group

Register of Deeds Stamp & File Number

4. Lot No. _____, Recorded Plat _____
5. Private Claims _____

1	A	B	C	D	E	F	G	H	I	J	K	L	M
2	6		5		4		3		2		1		
3													
4	7		8		9		10		11		12		
5													
6	18		17		16		15		14		13		
7													
8	19		20		21		22		23		24		
9													
10	30		29		28		27		26		25		
11													
12	31		32		33		34		35		36		
13													

I, DALE L. KESLER, in a field survey on AUG 13, 1997 do hereby state that under requirements of P.A. 74, Michigan P.A. of 1970, the corner points mentioned in lines 1 and 2 above were in conformance with regulations and rules therefore as required in the current manual of survey instructions of the United States Department of the Interior, Bureau of Land Management or by a decree of a Court of Law and /or that the corner points mentioned in lines 3, 4 and 5 above were in conformance with the rules of the Michigan Board of Land Surveyors or by a Decree of a Court of Law; established, re-established, monumented, recovered, found as expressed below:

NOTE: Not more than 2 corners, all in the same town and range, may be recorded on this certificate.

A. Description of original monument and accessories and/or subsequent restoration:


- *JULY 1828 SURVEY BY WILLIAM BROOKFIELD. INTERSECT NORTH BOUNDARY AT 13" W. OAK & 3.8 (209.88) CH. WEST OF POST.
- *JULY 1946 SURVEY BY E. JAMES FOUND CORNER MEASURED SOUTH 50 FEET TO IRON.
- *JAN. 1962 SURVEY BY JOHN CORBIT. MEASURED EAST 209.88 FEET TO THE S 1/4 COR. SEC. 33, MEASURED 233.9 FEET SOUTH TO IRON.
- *JULY 1971 SURVEY BY H. DONALD PEIRCE FOUND PK NAIL AT THE NE COR. SECTION 4-7-15. 18" HICKORY S 65 DEGREES W 65.30'; POWER POLE S 25 DEGREES EAST 80.0'.
- *SEPT. 1975 MICHIANA SURVEYORS FOUND 1/2" IRON BAR.
- *JAN. 27, 1977 SURVEY BY ROBERT PRESTINE NOTES NE CORNER SECTION 4-7-15, 209.88' W OF SE CORNER SECTION 33-6-15.
- *JUNE 20, 1986 SURVEY COMPLETED BY WIGHTMAN-PEIRCE, INC. INDICATES 1/2" REBAR FOUND AT NORTHWEST CORNER OF SECTION 3.

B. Description of corner evidence found and/or method applied in restoring or reestablishing corner:

NO MONUMENT WAS FOUND AT THIS CORNER. REESTABLISHED THE CORNER AT THE GOVERNMENT JOG OF 209.88' WEST OF SE CORNER OF SECTION 33, T6S, R15W AND ON LINE BETWEEN THE SOUTH QUARTER CORNER OF SECTION 33, T6S, R15W AND THE SE CORNER OF SECTION 33, T6S, R15W.

C. Description of monument for corner and accessories established to perpetuate locating the position of the corner:

SET 3/4" IRON PIPE WITH ALUMINUM CAP IN MONUMENT BOX AND IS ACCEPTED AS A CAREFUL AND FAITHFUL REESTABLISHMENT OF THE POSITION OF THE ORIGINAL CORNER.
C/L FACE CONCRETE PILLAR N 76 DEGREES 35' E 215.64'
PK NAIL IN POWER POLE N 76 DEGREES 52' E 224.62'
PK NAIL IN POWER POLE S 38 DEGREES 48' 20' E 66.10'
NE CORNER CONCRETE BLK. HOUSE S 20 DEGREES 53'40' W 159.22'
SE COR. SECTION 33, T6S, R15W, EAST 209.88'

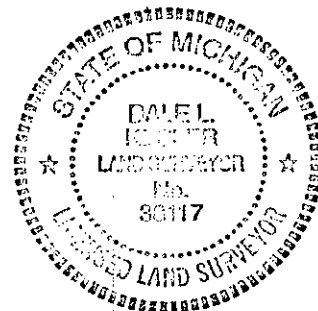

Signed by Dale L Kesler
Surveyor's Michigan License No. 38117

Date 12/24/97