

FEB 19 1998

Liber 00003 Page 0127

SECTION

LAND CORNER RECORDATION CERTIFICATE
Filing Requirement of Act 74, Mich. P.A. 1970
CASS COUNTY REMONUMENTATION

For corners in CASS (County)

Located In: T 7S R 15W Corner Code # H-1

STATE OF MICHIGAN COUNTY OF CASS Recorded

12-26-1997 11:55:43

Ann L. Simmons REGISTER OF DEEDS

Vertical text: Ratified by Peer Group In Accordance With P.A. 245 Chairman Dale Kesler Date Aug 19, 1997

Register of Deeds Stamp & File Number

1. Public Land Survey JEFFERSON TWP.

2. Property Controlling in Section

3. Miscellaneous Property in Sec.

4. Lot No. , Recorded Plat

5. Private Claims

I, DALE L. KESLER, in a field survey on AUG. 13, 1997 do hereby state that under requirements of P.A. 74, Michigan P.A. of 1970, the corner points mentioned in lines 1 and 2 above were in conformance with regulations and rules therefore as required in the current manual of survey instructions of the United States Department of the Interior, Bureau of Land Management or by a decree of a Court of Law and /or that the corner points mentioned in lines 3, 4 and 5 above were in conformance with the rules of the Michigan Board of Land Surveyors or by a Decree of a Court of Law; established, re-established, monumented, recovered, found as expressed below:

NOTE: Not more than 2 corners, all in the same town and range, may be recorded on this certificate.

A. Description of original monument and accessories and/or subsequent restoration:

THIS CORNER WAS NOT ORIGINALLY SET.


B. Description of corner evidence found and/or method applied in restoring or reestablishing corner:

NO MONUMENT WAS FOUND AT THIS CORNER. REESTABLISHED CORNER AT THE MIDWAY POINT AND ON LINE BETWEEN THE S 1/4 CORNER OF SECTION 34, T6S, R15W AND THE SW CORNER OF SECTION 34, T6S, R15W.

C. Description of monument for corner and accessories established to perpetuate locating the position of the corner:

SET 3/4" IRON PIPE WITH ALUMINUM CAP IN A MONUMENT BOX. THIS POSITION WAS NOT ESTABLISHED BY ORIGINAL GOVERNMENT SURVEYORS. THIS MONUMENT IS ACCEPTED AS THE BEST AVAILABLE EVIDENCE OF THE POSITION OF THE CORNER.

- PK NAIL IN POWER POLE N 75 DEGREES 38' E 280.81'
R.O.W. 1/2" BAR CAPPED N 70 DEGREES 01' W 146.10'
PK NAIL IN POWER POLE N 11 DEGREES 53' W 58.47'
PK NAIL IN POWER POLE S 45 DEGREES 48' W 101.30'
S 1/4 COR. SECTION 34, T6S, R15W, EAST 236.28'

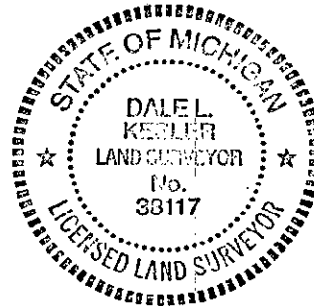

Grid table with columns A-M and rows 1-13. A dot is marked at the intersection of column H and row 1.

Signed by Dale Kesler

Date 12/24/97

Surveyor's Michigan License No. 38117