

Ratified by Peer Group  
In Accordance With P.A. 345

Chairman Dale L. Keen  
Date December 20, 1995

Liber 00003 Page 0047

CASS COUNTY REMONUMENTATION  
LAND CORNER RECORDATION CERTIFICATE  
Filing Requirement of Act 74, Mich. P.A. 1970

For corners in

CASS (County)	Located In:	Corner Code #
1. Public Land Survey	T <u>7</u> S R <u>16</u> W	<u>A-4</u>
	T _____ R _____	_____
	T _____ R _____	_____
	T _____ R _____	_____
2. Property Controlling in Section	S _____ T _____ R _____	_____
	S _____ T _____ R _____	_____
3. Miscellaneous Property in Sec.	S _____ T _____ R _____	_____
	S _____ T _____ R _____	_____

STATE OF MICHIGAN  
COUNTY OF CASS  
Recorded

12-28-1995 16:11:18

Ann L. Simmons  
REGISTER OF DEEDS

Register of Deeds Stamp & File Number

4. Lot No. \_\_\_\_\_, Recorded Plat \_\_\_\_\_  
5. Private Claims \_\_\_\_\_

	A	B	C	D	E	F	G	H	I	J	K	L	M
2	6	5	4	3	2	1							
3													
4	7	8	9	10	11	12							
5													
6	18	17	16	15	14	13							
7													
8	19	20	21	22	23	24							
9													
10	30	29	28	27	26	25							
11													
12	31	32	33	34	35	36							
13													

I, Robert W. Prestine, in a field survey on December 5, 1995, do hereby certify that under requirements of P.A. 74, Michigan P.A. of 1970, the corner points mentioned in lines 1 and 2 above were in conformance with regulations and rules theretore as required in the current manual of survey instructions of the United States Department of the Interior, Bureau of Land Management or by a decree of a Court of Law and/or that the corner points mentioned in lines 3, 4 and 5 above were in conformance with the rules of the Michigan Board of Land Surveyors or by a Decree of a Court of Law; established, re-established, monumented, re-monumented, recovered, found as expressed below:

NOTE: Not more than 4 corners, all in the same town and range, may be recorded on this certificate.

A. Description of original monument and accessories and/or subsequent restoration:

A-4 West Quarter corner Section 7, T 7 S., R. 16 W.

This corner not set by Govt.

B. Description of corner evidence found and/or method applied in restoring or reestablishing corner:

A-4

Found 3/4" iron, no monument, Southwest lot 5, recorded Plat of Misty Acres, by H.L. Dreher C.E. 3297, 1962

C. Description of monument for corner and accessories established to perpetuate locating the position of the corner:

A-4

Set 4" round Cass County Remonumentation monument.

3/4" iron, no monument


S.W. corner building (conc. fnd.) N 47° E 7.0'

Center of 10" Maple N 7° E 73.15'

Center of 15" Pine N 35° W 33.55'

7.6' North, monument S.E. corner lot 4, Misty Acres #1 (Berrien County corner).

This position is accepted as a careful and faithful reestablishment of the position of the original corner.

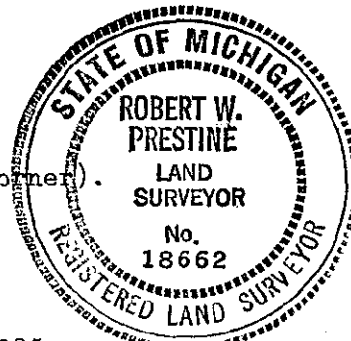

Signed by Robert W. Prestine

Date December 28, 1995

Surveyor's Michigan License No. 18662