

Ratified by Peer Group
In Accordance With P.A. 345

Chairman Dale C. Kuhl
Date December 20, 1995

CASS COUNTY REMONUMENTATION
LAND CORNER RECORDATION CERTIFICATE
Filing Requirement of Act 74, Mich. P.A. 1970

Liber 00003 Page 0048

STATE OF MICHIGAN
COUNTY OF CASS
Recorded

12-28-1995 16:11:27

Ann L. Simmons
REGISTER OF DEEDS

Register of Deeds Stamp & File Number

CASS (County)	Located In:	Corner Code #
1. Public Land Survey	T 7 S R 16 W	A-5
	T _____ R _____	_____
	T _____ R _____	_____
	T _____ R _____	_____
2. Property Controlling in Section	S _____ T _____ R _____	_____
	S _____ T _____ R _____	_____
3. Miscellaneous Property in Sec.	S _____ T _____ R _____	_____
	S _____ T _____ R _____	_____
4. Lot No. _____, Recorded Plat _____		
5. Private Claims _____		

	A	B	C	D	E	F	G	H	I	J	K	L	M
2	6	5	4	3	2	1							
3													
4	7	8	9	10	11	12							
5													
6	18	17	16	15	14	13							
7													
8	19	20	21	22	23	24							
9													
10	30	29	28	27	26	25							
11													
12	31	32	33	34	35	36							
13													

I, Robert W. Prestine, in a field survey on December 5, 1995, do hereby certify that under requirements of P.A. 74, Michigan P.A. of 1970, the corner points mentioned in lines 1 and 2 above were in conformance with regulations and rules therefore as required in the current manual of survey instructions of the United States Department of the Interior, Bureau of Land Management or by a decree of a Court of Law and/or that the corner points mentioned in lines 3, 4 and 5 above were in conformance with the rules of the Michigan Board of Land Surveyors or by a Decree of a Court of Law; established, re-established, monumented, re-monumented, recovered, found as expressed below:

NOTE: Not more than 4 corners, all in the same town and range, may be recorded on this certificate.

A. Description of original monument and accessories and/or subsequent restoration:

A-5 Southwest corner Section 7, T. 7 S., R. 16 W.

Govt. wits gone.

Wm. Brookfield D.S. June 1828


B. Description of corner evidence found and/or method applied in restoring or reestablishing corner:

A-5
Found stone with iron bent over.
H.L. Dreher C.E. #3297, stone 1919
M.D.O.T. Sept. 30, 1971 iron over stone.
Wits all O.K.

C. Description of monument for corner and accessories established to perpetuate locating the position of the corner:

A-5
Set 3/4" x 24" iron bent over stone with remon cap in monument box.
Center 28" Maple N 36° E 31.52'
Center 10" Spruce N 54° E 36.75'
Center 30" Twin Maple S 22° E 52.05'
Center conc. post N 5° W 16.15'
6.5'± N of center Gravel Road.
Berrien County corner South 10.56'
This position is accepted as a careful and faithful reestablishment of the position of the original corner.

RECEIVED
MAR 27 1996
COMMISSION

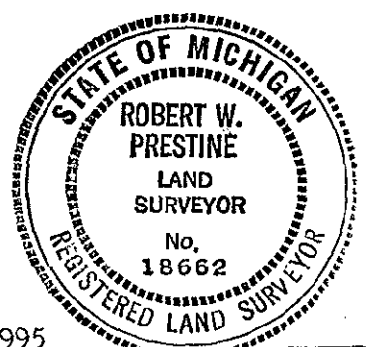

Signed by Robert W. Prestine

Date December 28, 1995

Surveyor's Michigan License No. 18662