

**REMONUMENTATION COMMISSION**  
**APR 06 1995**

STATE OF MICHIGAN  
 CASS COUNTY  
 RECEIVED FOR RECORD

**LAND CORNER RECORDATION CERTIFICATE**  
 Filing Requirement of Act 74, Mich. P.A. 1970

1994 DEC 28 PM 1 47

CASS COUNTY REMONUMENTATION

corners in  
 CASS  
 (County)

Located In: Corner Code #

Public Land Survey	T	7 S	R	16 W	D-1
	T		R		
	T		R		
	T		R		
Property Controlling in Section	S		T	R	
	S		T	R	
Miscellaneous Property in Sec.	S		T	R	
	S		T	R	

*Ann L. Simmons*  
 CLERK/REGISTER

LIBER 2 PAGE 371

Register of Deeds Stamp & File Number

Validated by Peer Group  
 In Accordance With P.A. 345  
 Chairman *Dale C. Kuhn*  
 Date *Dec 22, 1993*

Lot No. \_\_\_\_\_, Recorded Plat \_\_\_\_\_  
 Private Claims \_\_\_\_\_

*December 9-93*

Robert W. Prestine, in a field survey on February 17, 1994,  
 hereby certify that under requirements of P.A. 74, Michigan P.A. of 1970, the corner points mentioned  
 in lines 1 and 2 above were in conformance with regulations and rules therefore as required in the  
 present manual of survey instructions of the United States Department of the Interior, Bureau of Land  
 Management or by a decree of a Court of Law and/or that the corner points mentioned in lines 3, 4 and 5  
 above were in conformance with the rules of the Michigan Board of Land Surveyors or by a Decree of a  
 Court of Law; established, re-established, monumented, re-monumented, recovered, found as  
 recited below:

	A	B	C	D	E	F	G	H	I	J	K	L	M
2	6		5		4		3		2		1		
3													
4	7		8		9		10		11		12		
5													
6	18		17		16		15		14		13		
7													
8	19		20		21		22		23		24		
9													
10	30		29		28		27		26		25		
11													
12	31		32		33		34		35		36		
13													

**Note: Not more than 4 corners, all in the same town and range, may be recorded on this certificate.**

Description of original monument and accessories and/or subsequent restoration:

D-1 North quarter corner Section 5, T. 7 S., R. 16 W.


Govt. did not set corner.

Description of corner evidence found and/or method applied in restoring or reestablishing corner:

Did not find corner, is no occupation or property line, Set corner on Township line  
 at prorated jog between Northwest and Northeast corner of Section 5, 125.97 feet East  
 of South quarter corner Section 32, T. 6 S., R. 16 W., 18 rods (297') West of  
 North & South fence which is property line, which distance is okay to corner set.

Description of monument for corner and accessories established to perpetuate locating the position of the corner:

Placed 4" x 5' plastic pipe in marsh. Water is 12" to 40" deep. Set Cass County  
 Remonumentation monument inside and placed 2 steel fence post along side. Set  
 monument 6" above water 0.3' South of East & West fence 125.97' East of South  
 quarter corner Section 32, T. 6 S., R. 16 W. (Monument)

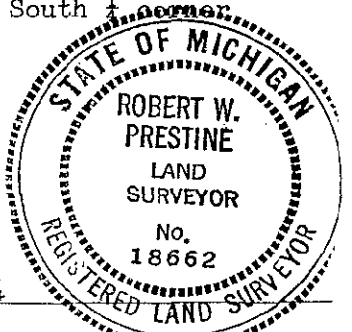

Set by Robert W. Prestine

Date December 27, 1994

Surveyor's Michigan License No. 18662