

COMMISSION  
REMONUMENTATION  
APR 06 1995

STATE OF MICHIGAN  
CASS COUNTY  
RECEIVED FOR RECORD

LAND CORNER RECORDATION CERTIFICATE

Filing Requirement of Act 74, Mich. P.A. 1970

CASS COUNTY REMONUMENTATION

1994 DEC 28 PM 1 47

or corners in  
CASS (County)  
Public Land Survey  
Property Controlling in Section  
Miscellaneous  
Property in Sec.

Located In: T 7 S R 16 W  
Corner Code # E-1

S T R  
S T R  
S T R  
S T R

*Ann L. Simmons*  
CLERK/REGISTER

LIBER 2 PAGE 373

Register of Deeds Stamp & File Number

Validated by Peer Group  
In Accordance With P.A. 345  
Chairman *Steve LeKahn*  
Date *Dec 22, 1993*

Lot No. \_\_\_\_\_, Recorded Plat \_\_\_\_\_  
Private Claims \_\_\_\_\_

*December 16-93*

**Robert W. Prestine**, in a field survey on December 20, 1994,  
hereby certify that under requirements of P.A. 74, Michigan P.A. of 1970, the corner points mentioned  
lines 1 and 2 above were in conformance with regulations and rules therefore as required in the  
current manual of survey instructions of the United States Department of the Interior, Bureau of Land  
Management or by a decree of a Court of Law and/or that the corner points mentioned in lines 3, 4 and 5  
above were in conformance with the rules of the Michigan Board of Land Surveyors or by a Decree of a  
Court of Law; established, re-established, monumented, re-monumented, recovered, found as  
expressed below:

A	B	C	D	E	F	G	H	I	J	K	L	M
2	6	5	4	3	2	1						
3												
4	7	8	9	10	11	12						
5												
6	18	17	16	15	14	13						
7												
8	19	20	21	22	23	24						
9												
10	30	29	28	27	26	25						
11												
12	31	32	33	34	35	36						
13												

**NOTE: Not more than 4 corners, all in the same town and range, may be recorded on this certificate.**

Description of original monument and accessories and/or subsequent restoration:


E-1 Northwest corner Section 4, T. 7 S., R 16 W.  
Govt.  
Set post, Wm. Brookfield 1827  
16" Oak on corner, intersection of North boundary 1.56' East of Southwest corner  
Section 33, T. 6 S., R. 16 W  
F. E. Smith, June 17, 1890, original tree gone, post Hickory 10" N 86° W 95 3/4 links  
Indiana & Michigan Electric Co. Survey April 30, 1931. Stone, no witness

Description of corner evidence found and/or method applied in restoring or reestablishing corner:

Did not find corners, excavated at distance East of Southwest corner Section 33,  
T. 6 S., R. 16 W., found soft and black area in sub soil, believed to be old  
post, area is on East edge of tree row and area has been tilled. Believe stone  
was removed.  
Recorded jog 1.56' = 102.96' measures = 102.78'

Description of monument for corner and accessories established to perpetuate locating the position of the corner:

Set Cass County Remonumentation monument.  
Nail & witness tag in North side 17" Wild Cherry S 88° W 6.30'  
Nail & witness tag in South side 28" Twin Hickory N 68° W 12.6'  
Nail & witness tag in East side 28" Triple Red Oak S 6° W 24.88' (East line)  
Northeast corner R.R Tie fence corner post S 70° W 10.83'  
102.78' East of Southwest corner Section 33, T. 6 S., R. 16 W. (Monument)

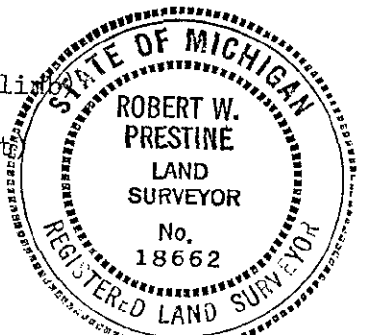

Recorded by *Robert W. Prestine* Date December 27, 1994

Surveyor's Michigan License No. 18662