

**SURVEY & REMONUMENTATION COMMISSION**  
**APR 06 1995**

STATE OF MICHIGAN  
 CASS COUNTY  
 RECEIVED FOR RECORD

**LAND CORNER RECORDATION CERTIFICATE**  
**Filing Requirement of Act 74, Mich. P.A. 1970**

CASS COUNTY REMONUMENTATION 1994 DEC 28 PM 1 47

Corner Code # \_\_\_\_\_  
 Located In: \_\_\_\_\_  
 Public Land Survey T 7 S R 16 W F-1  
 T \_\_\_\_\_ R \_\_\_\_\_  
 T \_\_\_\_\_ R \_\_\_\_\_  
 T \_\_\_\_\_ R \_\_\_\_\_  
 Property Controlling S \_\_\_\_\_ T \_\_\_\_\_ R \_\_\_\_\_  
 in Section S \_\_\_\_\_ T \_\_\_\_\_ R \_\_\_\_\_  
 Miscellaneous S \_\_\_\_\_ T \_\_\_\_\_ R \_\_\_\_\_  
 Property in Sec. S \_\_\_\_\_ T \_\_\_\_\_ R \_\_\_\_\_

*Carol L. Simmons*  
 CLERK/REGISTER

LIBER 2 PAGE 375

Register of Deeds Stamp & File Number

Validated by Peer Group  
 In Accordance With P.A. 345  
 Chairman Dale C. Seal  
 Date Dec 22, 1993

Lot No. \_\_\_\_\_, Recorded Plat \_\_\_\_\_  
 Private Claims \_\_\_\_\_

December 21 - 93

Robert W. Prestine in a field survey on December 20, 1994, hereby certify that under requirements of P.A. 74, Michigan P.A. of 1970, the corner points mentioned in lines 1 and 2 above were in conformance with regulations and rules therefore as required in the present manual of survey instructions of the United States Department of the Interior, Bureau of Land Management or by a decree of a Court of Law and/or that the corner points mentioned in lines 3, 4 and 5 above were in conformance with the rules of the Michigan Board of Land Surveyors or by a Decree of a Court of Law; established, re-established, monumented, re-monumented, recovered, found as recorded below:

	A	B	C	D	E	F	G	H	I	J	K	L	M
2	6	5	4	3	2								
3													
4	7	8	9	10	11	12							
5													
6	18	17	16	15	14	13							
7													
8	19	20	21	22	23	24							
9													
10	30	29	28	27	26	25							
11													
12	31	32	33	34	35	36							
13													

**NOTE: Not more than 4 corners, all in the same town and range, may be recorded on this certificate.**

Description of original monument and accessories and/or subsequent restoration:


- F-1 North quarter corner Section 4, T. 7 S., R. 16 W. Not set by Govt.
- F.E. Smith, June 17, 1890, Yellow Oak 24" N 45 1/3° E 63 links
- J.S. Haines, May 21, 1903, set stone White Oak 14" S 76° E 15 1/2 links
- H.L. Dreher 1953 & 1958 iron
- R.W. Prestine 1972, iron and stone Dec. 9, 1992

Description of corner evidence found and/or method applied in restoring or reestablishing corner:

Found 1 1/2" iron beside stone.

Description of monument for corner and accessories established to perpetuate locating the position of the corner:

- Removed stone and set Cass County remonumentation monument along side 1 1/2" pipe
- Nail & witness tag on East side 28" Oak N 26° W 5.42'
- Nail & witness tag on West side 6" Maple N 10° W 17.3'
- Nail & witness tag on Northwest side 10" White Oak N 64° E 25.82'
- Nail & witness tag on East side telephone pole S 18° W 10.02'
- Center line of road West 36.5' ±
- 36.46' East of South quarter corner Section 33, T. 6 S., R. 16 W. (Monument)

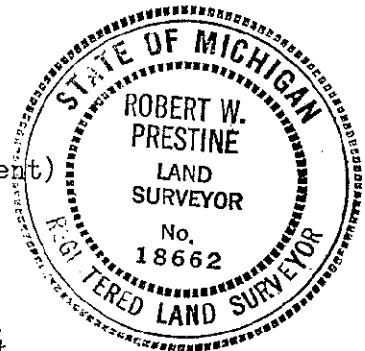

Recorded by *Robert W. Prestine*

Date December 27, 1994

Surveyor's Michigan License No. 18662