

SURVEY & REMONUMENTATION

FEB 19 1998

Liber 000003 Page 0139

LAND CORNER RECORDATION CERTIFICATE
Filing Requirement of Act 74, Mich. P.A. 1970
CASS COUNTY REMONUMENTATION

SECTION

For corners in <u>CASS</u> (County)	Located In:	Corner Code #
1. Public Land Survey Howard Twp.	T <u>7S</u> R <u>16W</u>	<u>I-13</u>
	T ___ R ___	_____
	T ___ R ___	_____
	T ___ R ___	_____
2. Property Controlling in Section	S ___ T ___ R ___	_____
	S ___ T ___ R ___	_____
3. Miscellaneous Property in Sec.	S ___ T ___ R ___	_____
	S ___ T ___ R ___	_____

STATE OF MICHIGAN
 COUNTY OF CASS
 Recorded

12-26-1997 11:59:34

Ann L. Simmons
 REGISTER OF DEEDS

Printed by Peer Group
 In Accordance with P.A. 945
 Chairman Dale Kesler
 Date Nov. 3, 1997

Register of Deeds Stamp & File Number

4. Lot No. _____, Recorded Plat _____
 5. Private Claims _____

I, Dale L. Kesler, in a field survey on OCT. 22, 19 97 do hereby state that under requirements of P.A. 74, Michigan P.A. of 1970, the corner points mentioned in lines 1 and 2 above were in conformance with regulations and rules therefore as required in the current manual of survey instructions of the United States Department of the Interior, Bureau of Land Management or by a decree of a Court of Law and /or that the corner points mentioned in lines 3, 4 and 5 above were in conformance with the rules of the Michigan Board of Land Surveyors or by a Decree of a Court of Law; established, re-established, monumented, recovered, found as expressed below:

NOTE: Not more than 2 corners, all in the same town and range, may be recorded on this certificate.

A. Description of original monument and accessories and/or subsequent restoration:

- *1827 William Brookfield. Set Post. Witnesses: 13" Oak N 72 degrees W 91 lks., 18" Oak N 55 3/4 degrees E 80 lks.
- *June 18, 1874 J.E. Bradt, County Surveyor. Identified corner, re-marked. Witnesses: 4" Oak S 89 degrees E 7 lks.
- *June 26, 1997 Wightman-Peirce, Inc. Found stone with cross. Witnesses: Center of 5 1/2" steel post in con. S 0.8', 10" Oak N 15 degrees E 23.3', Oak S 22 degrees E 21.0', RR tie fence corner post 31.5'

B. Description of corner evidence found and/or method applied in restoring or reestablishing corner:


Found stone with cross on top. Accepted stone as best evidence of corner.

C. Description of monument for corner and accessories established to perpetuate locating the position of the corner:

Set concrete monument with aluminum cap in place of stone and is accepted as a careful and faithful perpetuation of the original corner.

- Center of 5 1/2" steel post in concrete Southwest 0.80'
- Nail & Tag 10" Oak N 15 degrees E 23.30'
- Nail & Tag 18" Oak S 22 degrees E 21.0'
- RR tie Corner post South 31.5'
- 1/2" iron bar 4.0' East 1/2" bar 4.0' South

	A	B	C	D	E	F	G	H	I	J	K	L	M
1													
2	6		5		4		3		2		1		
3													
4	7		8		9		10		11		12		
5													
6	18		17		16		15		14		13		
7													
8	19		20		21		22		23		24		
9													
10	30		29		28		27		26		25		
11													
12	31		32		33		34		35		36		
13													

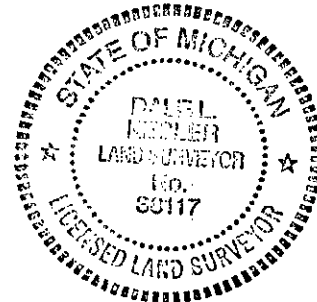

Signed by Dale Kesler
 Surveyor's Michigan License No. 38117

Date 12/4/97