

Attested by Peer Group
 Accordance With P.A. 345
 Chairman Dale L. Kern
 to October 5, 1995
 For corners in Porter Township

**CASS COUNTY REMONUMENTATION
 LAND CORNER RECORDATION CERTIFICATE
 Filing Requirement of Act 74, Mich. P.A. 1970**

STATE OF MICHIGAN
 COUNTY OF CASS
 Recorded

02-13-1996 08:24:03

Ann L. Simmons
 REGISTER OF DEEDS

Liber 00003 Page 0053

Register of Deeds Stamp & File Number

Cass (County)	Located In:	Corner Code #
Public Land Survey	T <u>8S</u> R <u>13W</u>	<u>M-2</u>
	T _____ R _____	_____
	T _____ R _____	_____
	T _____ R _____	_____
Property Controlling in Section	S _____ T _____ R _____	_____
	S _____ T _____ R _____	_____
Miscellaneous Property in Sec.	S _____ T _____ R _____	_____

MAR 27 1996
 COMMISSION

Lot No. _____, Recorded Plat _____
 Private Claims _____

NOTE: This document is to correct a previously recorded
 LCRC in Liber 00003, Page 0018.

Christian F. Marbach, in a field survey on November 14, 19 95,
 hereby certify that under requirements of P.A. 74, Michigan P.A. of 1970, the corner points mentioned
 in lines 1 and 2 above were in conformance with regulations and rules therefore as required in the
 current manual of survey instructions of the United States Department of the Interior, Bureau of Land
 Management or by a decree of a Court of Law and/or that the corner points mentioned in lines 3, 4 and 5
 above were in conformance with the rules of the Michigan Board of Land Surveyors or by a Decree of a
 Court of Law; established, re-established, monumented, re-monumented, recovered, found as
 expressed below:

NOTE: Not more than 4 corners, all in the same town and range, may be recorded
 on this certificate.


	A	B	C	D	E	F	G	H	I	J	K	L	M
2	6	5	4	3	2	1							
3													
4	7	8	9	10	11	12							
5													
6	18	17	16	15	14	13							
7													
8	19	20	21	22	23	24							
9													
10	30	29	28	27	26	25							
11													
12	31	32	33	34	35	36							
13													

Description of original monument and accessories and/or subsequent restoration:
 Original Monument: Post set 40 chains South of NE cor. Sec. 1, T8S, R13W (Britain, 1828)
 (M-3) Post set 80 chains South
 Accessories: 10" Blue Ash S 50° W 16 Links
 7" Beech N 14½° W 33 Links
 Subsequent Restoration: Liber 2, Page 269; Daniel Rahilly established corner equidistant and
 on line between NE cor. Sec. 1, T8S, R13W and SE cor. Sec. 1, T8S,
 R13W, distances as follows:
 NE cor. Sec. 1 to E½ cor. Sec. 1 = 2658.97' (1983)
 E½ cor. Sec. 1 to SE cor. Sec. 1 = 2658.97' (1983)
 Set 3/4" pipe in monument box.

Description of corner evidence found and/or method applied in restoring or reestablishing corner:
 Evidence Found: Monument box, no iron found.

References Found: N 81° E 300.0' SW cor. house, other searched for but none found

Established corner as follows:
 SE cor. Sec. 1 to E½ cor. Sec. 1 = 40.00 chains (Britain, 1828)
 2658.97' (Rahilly, 1983)
 2659.07' (C. Marbach, 1995)
 E½ cor. Sec. 1 to NE cor. Sec. 1 = 40.00 chains (Britain, 1828)
 2658.97' (Rahilly, 1983)
 2659.08' (C. Marbach, 1995)

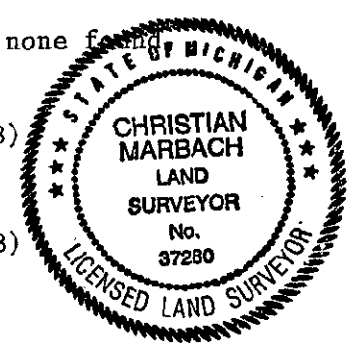

Set corner equidistant from SE corner to NE corner Section 1, T8S, R13W.

Description of monument for corner and accessories established to perpetuate locating the position of the corner:
 Monument: 1" iron pipe (30" long) with aluminum tablet stamped "Cass County Remonumentation",
 reset in 8" diam. monument box.

Witnesses: N 75° E 82.25' "Pass with Care" road sign post.
 S 45° E 13.52' P.K. Nail with washer set in pavement.
 S 45° W 14.15' P.K. Nail with washer set in pavement.
 S 45° W 36.38' Northerly post of "Mottville" sign.
 N 20° W 40.90' "Enter Cass County" sign.

And is accepted as a
 careful and faithful
reestablishment of the
 position of the original
 corner.

Monument is 7.2' North of edge of East bound lane, 10.5' North of edge of asphalt
 shoulder, 7.5' South of centerline.

Attested by Chris F. Marbach Date 2-7-96

Surveyor's Michigan License No. 37280