


Cass County Remonumentation Program
LAND CORNER RECORDATION CERTIFICATE

Filing Requirement of Act 74, Mich. P.A. 1970

For corners in W 1/4 Post Section 7, Mason Twp.

<u>Cass</u> (County)	Located In:	Corner Code #
1. Public Land Survey	T <u>8S</u> R <u>14W</u>	<u>A - 4</u>
	T _____ R _____	_____
	T _____ R _____	_____
	T _____ R _____	_____
2. Property Controlling in Section	S _____ T _____ R _____	_____
	S _____ T _____ R _____	_____
3. Miscellaneous Property in Sec.	S _____ T _____ R _____	_____
	S _____ T _____ R _____	_____
4. Lot No. _____, Recorded Plat _____		
5. Private Claims _____		

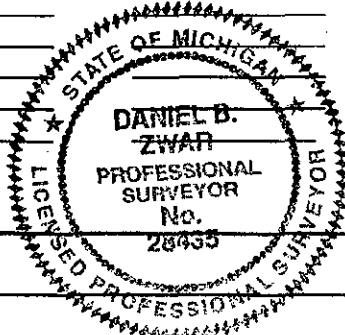

STATE OF MICHIGAN
COUNTY OF CASS
Recorded
12-22-1999 12:50:32
Ann L. Simmons
REGISTER OF DEEDS

Validated by Peer Group
In Accordance With P.A. 345
Chairman Dale G. Cal
Date Dec 7, 1999

Register of Deeds Stamp & File Number

	A	B	C	D	E	F	G	H	I	J	K	L	M
1													
2	6		5		4		3		2		1		
3													
4	7		8		9		10		11		12		
5													
6	18		17		16		15		14		13		
7													
8	19		20		21		22		23		24		
9													
10	30		29		28		27		26		25		
11													
12	31		32		33		34		35		36		
13													

I, Daniel B. Zwar, in a field survey on Dec. 13, 19 99 do hereby state that under requirements of P.A. 74, Michigan P.A. of 1970, the corner points mentioned in lines 1 and 2 above were in conformance with regulations and rules therefore as required in the current manual of survey instructions of the United States Department of the Interior, Bureau of Land Management or by a decree of a Court of Law and /or that the corner points mentioned in lines 3, 4 and 5 above were in conformance with the rules of the Michigan Board of Land Surveyors or by a Decree of a Court of Law; established, re-established, monumented, recovered, found as expressed below:

NOTE: Not more than 2 corners, all in the same town and range, may be recorded on this certificate.

A. Description of original monument and accessories and/or subsequent restoration:

- This corner not originally set by GLO.
- 1973 - H.D. Peirce - Stone with "X" - E 1/4 post Sec 12-8-15, North 206.78'; center Section 7 East 2060.85'.
- 1973 - R.W. Prestine - Found E 1/4 post Section 12-8-15 North 206.78'.
- 1993 - D.L. Kesler - Shows 206.78' N to E 1/4 post Sec 12-8-15.
- 1999 - D.L. Kesler - 3/4" iron - same jog North; steel post N 40° E 11.4'; Steel post N 62° E 10.4'; Power pole N 67° W 69.50'; 30" Hickory S 80° E 97.50'; Center Section 7 - East 2061.02'.

B. Description of corner evidence found and/or method applied in restoring or reestablishing corner:

- 1999 - D.B. Zwar - Found 3/4" pipe per witnesses. Straddled & removed found large stone with "X" at correct location on N-S section line removed - found nothing else.

C. Description of monument for corner and accessories established to perpetuate locating the position of the corner:

- 1999 - D.B. Zwar - Set standard Cass County remon pipe and cap in mon box to stone location buried 6" deep in gravel road (Grange St.)

New Witnesses: Iron pipe is at E end of E-W fence South 10.7' & East 3'.
PK AEP pole (C568-120) N 69° W 70.01';
Tel Ped N 16° E 87.9';
PK in 30" Hickory S 74° E 96.51';
PK in 8" Oak S 16° W 55.41'.

This position not established by original government surveyors. This monument is accepted as the best available evidence of the position of the corner. Center Section 7-8-14 East 2061.12; SW corner Section 7-8-14 South 2644.43'.

Signed by Daniel B Zwar

Date Dec 22, 1999

Surveyor's Michigan License No. 28435