

Cass County Remonumentation Program  
LAND CORNER RECORDATION CERTIFICATE  
Filing Requirement of Act 74, Mich. P.A. 1970

For corners in Cass (County) Located In: NW corner, Section 18, Mason Twp. Corner Code # A-5

	Cass (County)	Located In:	Corner Code #
1. Public Land Survey		T <u>8S</u> R <u>14W</u>	<u>A-5</u>
		T _____ R _____	_____
		T _____ R _____	_____
		T _____ R _____	_____
2. Property Controlling in Section	S _____	T _____ R _____	_____
	S _____	T _____ R _____	_____
3. Miscellaneous Property in Sec.	S _____	T _____ R _____	_____
	S _____	T _____ R _____	_____

STATE OF MICHIGAN  
COUNTY OF CASS  
Recorded

12-22-1999 12:51:01

Ann L. Simmons  
REGISTER OF DEEDS

Register of Deeds Stamp & File Number

Ratified by Peer Group  
In Accordance With P.A. 245  
Chairman Dale G. [Signature]  
Date Apr 7, 1999

4. Lot No. \_\_\_\_\_, Recorded Plat \_\_\_\_\_  
5. Private Claims \_\_\_\_\_

I, Daniel B. Zwar, in a field survey on Dec. 13, 19 99 do hereby state that under requirements of P.A. 74, Michigan P.A. of 1970, the corner points mentioned in lines 1 and 2 above were in conformance with regulations and rules therefore as required in the current manual of survey instructions of the United States Department of the Interior, Bureau of Land Management or by a decree of a Court of Law and /or that the corner points mentioned in lines 3, 4 and 5 above were in conformance with the rules of the Michigan Board of Land Surveyors or by a Decree of a Court of Law; established, re-established, monumented, recovered, found as expressed below:

	A	B	C	D	E	F	G	H	I	J	K	L	M
1													
2	6		5		4		3		2		1		
3													
4	7		8		9		10		11		12		
5													
6	18		17		16		15		14		13		
7													
8	19		20		21		22		23		24		
9													
10	30		29		28		27		26		25		
11													
12	31		32		33		34		35		36		
13													

NOTE: Not more than 2 corners, all in the same town and range, may be recorded on this certificate.

A. Description of original monument and accessories and/or subsequent restoration:

1828 - R. Clark Jr. - Intersected West Boundary - 3.16 ch South of Ontwa corner (208.56'); 18" White Oak N 30 3/4 E 1.2 ch.; 18" W. Oak S 32 E 51 1/2 lks.

No other history found.

B. Description of corner evidence found and/or method applied in restoring or reestablishing corner:

1999 - D.B. Zwar - Fd iron pipe 0.83' East of Ontwa Line 207.79' South of Ontwa corner. Found nothing else.

C. Description of monument for corner and accessories established to perpetuate locating the position of the corner:

1999 - D.B. Zwar - Set standard Cass County remon concrete monument West of bent pipe location but on line between M-6 & M-5 (Ontwa).


Witnesses: 1/2" iron pipe East 0.83'; 1/2" rod set E 100';  
Set 1/2" iron rod West 100';  
NE corner set 13-8-15 North 207.79';  
West 1/4 post Sec 7 North 2644.43';  
West 1/4 post Sec 18 South 2641.27'.

This location is accepted as the best available evidence of the position of the original corner.

Signed by Daniel B. Zwar

Date Dec 22, 1999

Surveyor's Michigan License No. 28435

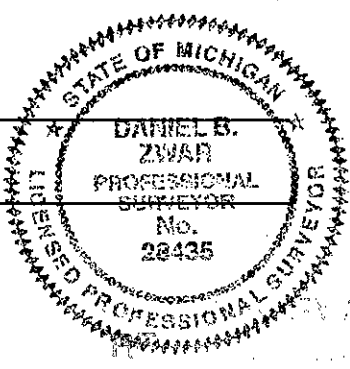

FORM APPROVED BY MICHIGAN STATE BOARD OF

FEB 4 2000

SECTION