

Cass County Remonumentation Program
LAND CORNER RECORDATION CERTIFICATE

Filing Requirement of Act 74, Mich. P.A. 1970

For corners in W ¼ Post Section 18, Mason Twp.

Cass (County)	Located In:	Corner Code #
1. Public Land Survey	T <u>8S</u> R <u>14W</u>	<u>A - 6</u>
	T _____ R _____	_____
	T _____ R _____	_____
	T _____ R _____	_____
2. Property Controlling in Section	S _____ T _____ R _____	_____
	S _____ T _____ R _____	_____
3. Miscellaneous Property in Sec.	S _____ T _____ R _____	_____
	S _____ T _____ R _____	_____

STATE OF MICHIGAN
COUNTY OF CASS
Recorded

12-22-1999 12:51:17

Ann L. Simmons
REGISTER OF DEEDS

Register of Deeds Stamp & File
Number

Ratified by Peer Group
In Accordance With P.A. 345
Chairman [Signature]
Date Dec. 7, 1999

4. Lot No. _____, Recorded Plat _____

5. Private Claims _____

I, Daniel B. Zwar, in a field survey on Dec. 13,
19 99 do hereby state that under requirements of P.A. 74, Michigan P.A. of
1970, the corner points mentioned in lines 1 and 2 above were in conformance
with regulations and rules therefore as required in the current manual of survey
instructions of the United States Department of the Interior, Bureau of Land
Management or by a decree of a Court of Law and /or that the corner points
mentioned in lines 3, 4 and 5 above were in conformance with the rules of the
Michigan Board of Land Surveyors or by a Decree of a Court of Law; established,
re-established, monumented, recovered, found as expressed below:

	A	B	C	D	E	F	G	H	I	J	K	L	M
1													
2	6		5		4		3		2		1		
3													
4	7		8		9		10		11		12		
5													
6	18		17		16		15		14		13		
7													
8	19		20		21		22		23		24		
9													
10	30		29		28		27		26		25		
11													
12	31		32		33		34		35		36		
13													

NOTE: Not more than 2 corners, all in the same town and range, may be recorded
on this certificate.

A. Description of original monument and accessories and/or subsequent restoration:

This corner not set by GLD.

No history found.

B. Description of corner evidence found and/or method applied in restoring or reestablishing corner:

1999 - D.B. Zwar - Found iron pipe at W. end of E-W fence. This location is 1987. 36' W of historic center of Section 18 and relative
to a straight line between NW & SW corner of 18 is 3' East of line and about 10 ½' South of the measured split. Also the East ¼
post section 13-8-15 is on this referenced line.

C. Description of monument for corner and accessories established to perpetuate locating the position of the corner:

1999 - D.B. Zwar - Peer group instructed me to place the standard cass remon concrete monument on the monumented Ontwa line
between M-6 and M-7 and at the split of the measured distance between the NW and SW corners of Section 18, Mason Twp.
Which I did.


Witnesses: Iron pipe is at W end of E-W fence South 10.7' & East 3'.
E ¼ Post Sec 13 Ontwa Twp North 206.73';
12" Cherry S 77° E 53.05';
15" Oak South S 38° E'
10" Oak South 10.1';
Center Section East 2002.90';
SW corner Section 18 South 2641.27' NW corner Sec 18 North 2641.27'

This position not established by original government surveyors. This monument is accepted as the best available evidence of the
position of the corner.

Signed by Daniel B. Zwar

Date Dec 22, 1999

Surveyor's Michigan License No. 28435

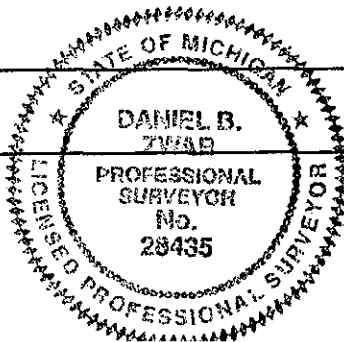

FORM APPROVED BY MICHIGAN STATE BOARD OF