

Cass County Remonumentation Program
LAND CORNER RECORDATION CERTIFICATE

Filing Requirement of Act 74, Mich. P.A. 1970

For corners in SW corner, Section 18, Mason Twp.

Cass (County)	Located In:	Corner Code #
1. Public Land Survey	T <u>8S</u> R <u>14W</u>	<u>A - 7</u>
	T _____ R _____	_____
	T _____ R _____	_____
	T _____ R _____	_____
2. Property Controlling in Section	S _____ T _____ R _____	_____
	S _____ T _____ R _____	_____
3. Miscellaneous Property in Sec.	S _____ T _____ R _____	_____
	S _____ T _____ R _____	_____

STATE OF MICHIGAN
COUNTY OF CASS
Recorded

12-22-1999 12:51:34

Ann L. Simmons
REGISTER OF DEEDS

Register of Deeds Stamp & File
Number

Ratified by Peer Group
In Accordance With P.A. 345
Chairman [Signature]
7/10/00

4. Lot No. _____, Recorded Plat _____

5. Private Claims _____

I, Daniel B. Zwar, in a field survey on Dec. 15,
19 99 do hereby state that under requirements of P.A. 74, Michigan P.A. of
1970, the corner points mentioned in lines 1 and 2 above were in conformance
with regulations and rules therefore as required in the current manual of survey
instructions of the United States Department of the Interior, Bureau of Land
Management or by a decree of a Court of Law and /or that the corner points
mentioned in lines 3, 4 and 5 above were in conformance with the rules of the
Michigan Board of Land Surveyors or by a Decree of a Court of Law; established,
re-established, monumented, recovered, found as expressed below:

	A	B	C	D	E	F	G	H	I	J	K	L	M
1													
2	6		5		4		3		2		1		
3													
4	7		8		9		10		11		12		
5													
6	18		17		16		15		14		13		
7													
8	19		20		21		22		23		24		
9													
10	30		29		28		27		26		25		
11													
12	31		32		33		34		35		36		
13													

NOTE: Not more than 2 corners, all in the same town and range, may be recorded
on this certificate.

A. Description of original monument and accessories and/or subsequent restoration:

1828 - R. Clark Jr. - Ran West between Section 18 & 19 and set corner 2.99 chains South of post (197.34'); 14" W. Oak N 62 1/2° E
69 1/2 lks.; 14" W. Oak S 51° E 70 lks.;

1997 - D.L. Kesler - Found centerline Asp Rd. N 6.40'; Tel Ped N 1° E 34.40'; 12" Maple N 45° W 65.35'; SE corner house N 20° W
150.40'; S 1/4 post East 1940.49'

B. Description of corner evidence found and/or method applied in restoring or reestablishing corner:

1999 - D.B. Zwar - Found straight 3/4" Pipe nothing else and some of Kesler witnesses.


C. Description of monument for corner and accessories established to perpetuate locating the position of the corner:

1999 - D.B. Zwar - Placed standard Cass remon pipe and cap to pipe location and added a mon box. This location is accepted as the
best available evidence of the position of the original corner.

Witnesses: Centerline pavement (Redfield Rd.) E-W North 6'; centerline conc drive (to North) West 30'; PK nail in following:

- 15" Locust N 35° W 65.76';
- 12" Maple N 10° E 48.18';
- 24" Maple N 40° E 56.33';
- Fence corner post N 05° E 35'

Signed by Daniel B Zwar

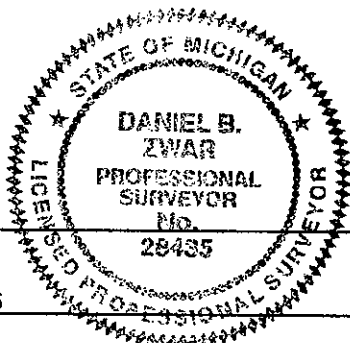

Date Dec 22, 1999

Surveyor's Michigan License No. 28435

FEB 24 2000

SECTION