

SURVEY & REMONUMENTATION

APR 26 1995

COMMISSION

LAND CORNER RECORDATION CERTIFICATE

Filing Requirement of Act 74, Mich. P.A. 1970

CASS COUNTY REMONUMENTATION

STATE OF MICHIGAN
CASS COUNTY
RECEIVED FOR RECORD

1994 DEC 29 PM 4 22

For corners in

CASS

(County)

Located In:

Corner Code #

1. Public Land Survey	T	8S	R	14W	I-5
SE Cor. Section 10	T		R		
	T		R		
	T		R		
	T		R		
2. Property Controlling in Section	S		T	R	
	S		T	R	
3. Miscellaneous Property in Sec.	S		T	R	
	S		T	R	

Amos D. Simmons
CLERK/REGISTER

LIBER 2 PAGE 398

Register of Deeds Stamp & File Number

Platified by Peer Group
In Accordance With P.A. 645
Chairman Dale C. Kesler
Date Dec 22, 1994

4. Lot No. _____ Recorded Plat _____
5. Private Claims _____

	A	B	C	D	E	F	G	H	I	J	K	L	M
2	6		5		4		3		2				
3													
4	7		8		9		10		11		12		
5									●				
6	18		17		16		15		14		13		
7													
8	19		20		21		22		23		24		
9													
10	30		29		28		27		26		25		
11													
12	31		32		33		34		35		36		
13													

I, Dale L. Kesler, in a field survey on December 19, 1994, do hereby certify that under requirements of P.A. 74, Michigan P.A. of 1970, the corner points mentioned in lines 1 and 2 above were in conformance with regulations and rules therefore as required in the current manual of survey instructions of the United States Department of the Interior, Bureau of Land Management or by a decree of a Court of Law and/or that the corner points mentioned in lines 3, 4 and 5 above were in conformance with the rules of the Michigan Board of Land Surveyors or by a Decree of a Court of Law; established, re-established, monumented, re-monumented, recovered, found as expressed below:

NOTE: Not more than 4 corners, all in the same town and range, may be recorded on this certificate.

A. Description of original monument and accessories and/or subsequent restoration:


- 1827 Robert Clark - Set wood post - 19" Beech tree South 83° West - 34 Links - 19" Sugar Maple tree - North 74° East - 8 Links
- 1879 Amos Smith - Identified witness and stone set by self - 7" Black walnut South 46° East - 61.0 Links
- 1882 Amos Smith - Found good stone, Hickory witness good first cut Robert Prestine Found monument box - No witnesses

B. Description of corner evidence found and/or method applied in restoring or reestablishing corner:

Found 1/2" iron bar in monument box under 3" of asphalt at the southeast corner of Section 10, T8S, R14W. Removed 1/2" iron, went down 12", found 1" iron pipe 3' long. Accepted 1/2" iron bar as best evidence of corner.

C. Description of monument for corner and accessories established to perpetuate locating the position of the corner:

- Set 3/4" standard 2' iron pipe with aluminum cap in place of 1/2" iron bar and the 1" iron pipe and is accepted as a careful and faithful perpetuation of the original corner.
- Set nail in 15" cedar - North 35° East - 43.51'
- Set PK main in power pole - North 20° West - 64.07'
- Set PK nail in Wood post - North 35° West - 36.70'
- Set PK nail in wood fence corner - South 45° West - 34.96'

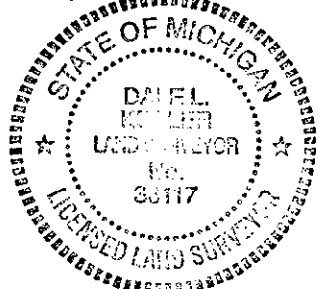

Signed by *Dale C. Kesler*

Date December 29, 1994

Surveyor's Michigan License No. 38117