

NOV 16 2000

SECTION

LAND CORNER RECORDATION CERTIFICATE
Filing Requirement of Act 74, Mich. P.A. 1970
CASS COUNTY REMONUMENTATION

For corners in
CASS
(County)

Located In: T 8S R 15W Corner Code # B-1

1. Public Land Survey
N 1/4 COR. SEC. 6

T R

T R

T R

2. Property Controlling
in Section S T R

S T R

3. Miscellaneous
Property in Sec. S T R

S T R

STATE OF MICHIGAN
COUNTY OF CASS
Recorded

11-29-1999 13:46:31

Ann L. Simmons
REGISTER OF DEEDS

Register of Deeds Stamp & File Number

Platified by Peer Group
In Accordance With P.A. 945
Chairman Dale C Kesler
Date Nov 9, 1999

4. Lot No. _____, Recorded Plat _____
5. Private Claims _____

I, DALE L. KESLER, in a field survey on OCTOBER 26, 1999 do hereby state that under requirements of P.A. 74, Michigan P.A. of 1970, the corner points mentioned in lines 1 and 2 above were in conformance with regulations and rules therefore as required in the current manual of survey instructions of the United States Department of the Interior, Bureau of Land Management or by a decree of a Court of Law and /or that the corner points mentioned in lines 3, 4 and 5 above were in conformance with the rules of the Michigan Board of Land Surveyors or by a Decree of a Court of Law; established, re-established, monumented, recovered, found as expressed below:

A	B	C	D	E	F	G	H	I	J	K	L	M
1	●											
2	6	5	4	3	2	1						
3												
4	7	8	9	10	11	12						
5												
6	18	17	16	15	14	13						
7												
8	19	20	21	22	23	24						
9												
10	30	29	28	27	26	25						
11												
12	31	32	33	34	35	36						
13												

NOTE: Not more than 2 corners, all in the same town and range, may be recorded on this certificate.

A. Description of original monument and accessories and/or subsequent restoration:

1827 WILLIAM BROOKFIELD. MEASURED WEST 40 CHAINS SET POST, 8" WHITE OAK N 75 E 18 (11.88 FEET), 15" WHITE OAK N 46 1/2 W 59 (38.94 FEET), MEASURED WEST 42 CHAINS INT. RANGE LINE.
AUG 13, 1976 BOB PRESTINE (L.C.R.C. LIBER 2, PG. 14), SET 1/2 IRON ON LINE WITH SE CORNER & SW CORNER OF SECTION AT PRORATED DISTANCE. CTR 4" HICKORY N 30 W 11.5, CTR 24" TWIN W. CHERRY S 45 W 5.8', FENCE COR. POST EAST 2.2' AND SOUTH 4.2'

B. Description of corner evidence found and/or method applied in restoring or reestablishing corner:


DID NOT FIND 1/2" IRON SET BY PRESTINE. FOUND ONE WITNESS FROM THE 1976 L.C.R.C. RE-ESTABLISHED CORNER BY PRORATION BETWEEN THE SW CORNER AND SE CORNER OF SECTION 31, T7S, R15W.

Liber 00003 Page 0225

C. Description of monument for corner and accessories established to perpetuate locating the position of the corner:

SET 3" X 36" CONCRETE MONUMENT WITH ALUMINUM CAP AND IS ACCEPTED AS A CAREFUL AND FAITHFUL RE-ESTABLISHMENT OF THE POSITION OF THE ORIGINAL CORNER.

- SET P.K. NAIL NORTH SIDE 26" WILD CHERRY (WIT. ALSO FROM PRESTINE) S 45 W 6.52
- SET P.K. NAIL IN 24" TRIPLE W. CHERRY NORTH 19.96
- SET P.K. NAIL IN 15" HICKORY EAST 15.75
- SET P.K. NAIL IN 9" WHITE OAK S 35 DEG. EAST 16.71

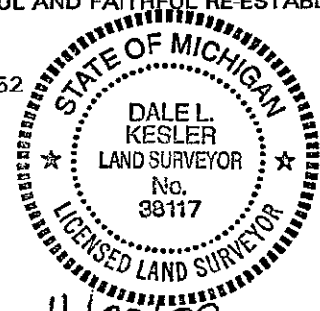

Signed by Dale C Kesler
Surveyor's Michigan License No. 38117

Date 11/23/99