

MAY 16 1997

**CASS COUNTY REMONUMENTATION**

Liber **00003** Page **0073**

**COMMISSION**

**LAND CORNER RECORDATION CERTIFICATE**  
**Filing Requirement of Act 74, Mich. P.A. 1970**

STATE OF MICHIGAN  
 COUNTY OF CASS  
 Recorded

For corners in **Ontwa Township**

Cass (County)	Located In:	Corner Code #
1. Public Land Survey	T <u>8S</u> R <u>15W</u>	<u>B-8</u>
	T _____ R _____	_____
	T _____ R _____	_____
	T _____ R _____	_____
2. Property Controlling in Section	S _____ T _____ R _____	_____
	S _____ T _____ R _____	_____
3. Miscellaneous Property in Sec.	S _____ T _____ R _____	_____
	S _____ T _____ R _____	_____
4. Lot No. _____, Recorded Plat _____		
5. Private Claims _____		

01-31-1997 10:52:15

Ann L. Simmons  
 REGISTER OF DEEDS

Ratified by Peer Group  
 In Accordance With P.A. 345  
 Chairman Paul C. Kew  
 Date 12-1-97

**Register of Deeds Stamp & File Number**

I, Christian F. Marbach, in a field survey on September 6, 19 96, do hereby certify that under requirements of P.A. 74, Michigan P.A. of 1970, the corner points mentioned in lines 1 and 2 above were in conformance with regulations and rules therefore as required in the current manual of survey instructions of the United States Department of the Interior, Bureau of Land Management or by a decree of a Court of Law and/or that the corner points mentioned in lines 3, 4 and 5 above were in conformance with the rules of the Michigan Board of Land Surveyors or by a Decree of a Court of Law; established, re-established, monumented, re-monumented, recovered, found as expressed below:

**NOTE: Not more than 4 corners, all in the same town and range, may be recorded on this certificate.**

A. Description of original monument and accessories and/or subsequent restoration:  
 Original Monument: Nothing set

Accessories: None

Subsequent Restoration: None found in records

(Sketch on reverse side)

	A	B	C	D	E	F	G	H	I	J	K	L	M
2	6		5		4		3		2		1		
3													
4	7		8		9		10		11		12		
5													
6	18		17		16		15		14		13		
7													
8	▲		20		21		22		23		24		
9													
10	30		29		28		27		26		25		
11													
12	31		32		33		34		35		36		
13													

B. Description of corner evidence found and/or method applied in restoring or reestablishing corner:

Evidence Found: No monument found.

North & South plow line found extending North from State line

(B-8) to (C-8):  $\frac{2640'}{5404.08'} = \frac{(B-8) \text{ to } (C-8)}{5462.69'}$ : 2668.62'

(A-8) to (B-8):  $\frac{2764.08'}{5404.08'} = \frac{(A-8) \text{ to } (B-8)}{5462.69'}$ : 2794.06'

(Based on pro-rating today's measurements with original survey)

(Continued on reverse side)

C. Description of monument for corner and accessories established to perpetuate locating the position of the corner:

Monument: Concrete monument (36" long)/rebar with aluminum tablet, 0.4' above ground. Tablet stamped "Cass County Remonumentation". This position not established by original government surveyors. This monument is accepted as the best available evidence of the position of the corner.

Accessories:

- Masonry nail in 30" Wild Cherry, S 89° E - 23.45'
- Masonry nail in 6" Wild Cherry, S 15° E - 11.95'
- Masonry nail in fork of 12" & 18" Wild Cherry, S 10° W - 12.55'
- Masonry nail in 4" Wild Cherry, S 87° W - 10.04'
- North & South field line extends North

Signed by Chris F. Marbach

Date 12-9-96

Surveyor's Michigan License No. 37280




A. (Sketch)

\* Marbach & Brady, 1995  
\*\* Jones (10/23/73, Liber 1, Pg. 325)  
\*\*\* Brookfield, 1827 (Original Survey)

5470.24'\*  
5469.53'\*\*  
5404.08'\*\*\*

\*\*2799.07' 2670.46'\*\*  
\*\*\* (41.88 ch. - 2764.08') (40 ch. - 2640.00')\*\*\*

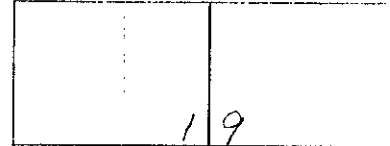

5462.69'\*

B. (Continued)

Method Applied: (B-8) to (C-8) - 2663.33'  
(A-8) to (B-8) - 2799.37'

(Based on location of North-South field line)