NOV 16 2000

SECTION

LAND CORNER RECORDATION CERTIFICATE
Filing Requirement of Act 74, Mich. P.A. 1970
CASS COUNTY REMONUMENTATION

For corners in CASS (County)

	Located In:	Corner Code #
1. Public Land Survey N 1/4 Sec. 5	T 8S R 15W	D-1
	T___ R___	
	T___ R___	
	T___ R___	
2. Property Controlling	S___ T___ R___	
in Section	S___ T___ R___	
3. Miscellaneous	S___ T___ R___	
Property in Sec.	S___ T___ R___	

STATE OF MICHIGAN
COUNTY OF CASS
Recorded

11-29-1999 13:47:02

Ann L. Simmons
REGISTER OF DEEDS

Ratified by Peer Group
In Accordance With P.A. 345
Chairman
Date Nov 9, 1999

Register of Deeds Stamp & File Number

4. Lot No. _____, Recorded Plat _____
5. Private Claims _____

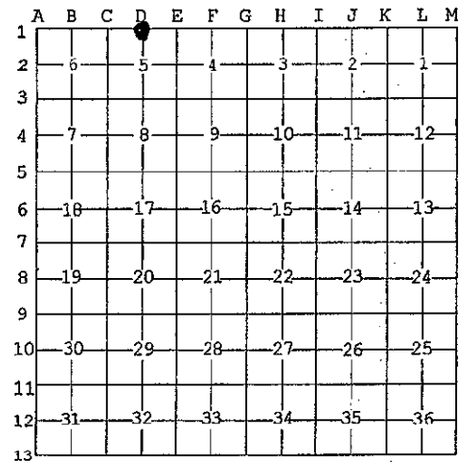

I, DALE L. KESLER, in a field survey on OCTOBER 26, 19 99 do hereby state that under requirements of P.A. 74, Michigan P.A. of 1970, the corner points mentioned in lines 1 and 2 above were in conformance with regulations and rules therefore as required in the current manual of survey instructions of the United States Department of the Interior, Bureau of Land Management or by a decree of a Court of Law and /or that the corner points mentioned in lines 3, 4 and 5 above were in conformance with the rules of the Michigan Board of Land Surveyors or by a Decree of a Court of Law; established, re-established, monumented, recovered, found as expressed below:

NOTE: Not more than 2 corners, all in the same town and range, may be recorded on this certificate.

A. Description of original monument and accessories and/or subsequent restoration:

1827 William Brookfield. Measured West 40 chains 1/4 Section Corner in pond measured West 80 chains.
April 26, 1871 Bradt, County Surveyor. South 1/4 Section Corner lost - established ½ way on line.

Liber 00003 Page 0228

B. Description of corner evidence found and/or method applied in restoring or reestablishing corner:

Did not find corner. Re-established corner midway and on line between the SW corner and SE corner of Section 32, T7S, R15W.

C. Description of monument for corner and accessories established to perpetuate locating the position of the corner:

Set 3/4" x 6' galvinized pipe with aluminum cap in a 6" PVC pipe in concrete and is accepted as a careful and faithful re-establishment of the position of the original corner.
PK Nail in 5" W. Cherry S 45 deg. W 20.37
PK Nail in 4" W. Cherry S 40 deg. W 12.09
PK Nail in 8" W. Cherry S 15 deg. W 16.79
Corner at South Edge Water of Pleasant Lake Drain

STATE OF MICHIGAN
DALE L. KESLER
LAND SURVEYOR
No. 38117
LICENSED LAND SURVEYOR

Signed by Dale L. Kesler Date 11/23/99

Surveyor's Michigan License No. 38117

FORM APPROVED BY MICHIGAN STATE BOARD OF PROFESSIONAL SURVEYORS, JAN. 28, 1971
REVISED MAY 14, 1975
REVISED JAN., 1983
REVISED OCT., 1995