

FEB 19 1998

Liber 00003 Page 0088

CASS COUNTY REMONUMENTATION LAND CORNER RECORDATION CERTIFICATE

SECTION For corners in Ontwa Township

Filing Requirement of Act 74, Mich. P.A. 1970 STATE OF MICHIGAN COUNTY OF CASS Recorded

Table with columns: Cass (County), Located In, Corner Code. Rows include Public Land Survey, Property Controlling in Section, Miscellaneous Property in Sec., Lot No., and Private Claims.

02-19-1997 14:21:20 Ann L. Simmons REGISTER OF DEEDS

Platified by Peer Group In Accordance With P.A. 345 Chairman [Signature] Date 7-11-97

Register of Deeds Stamp & File Number

I, Christian F. Marbach, in a field survey on September 6, 1996, do hereby certify that under requirements of P.A. 74, Michigan P.A. of 1970, the corner points mentioned in lines 1 and 2 above were in conformance with regulations and rules therefore as required in the current manual of survey instructions of the United States Department of the Interior, Bureau of Land Management or by a decree of a Court of Law and/or that the corner points mentioned in lines 3, 4 and 5 above were in conformance with the rules of the Michigan Board of Land Surveyors or by a Decree of a Court of Law; established, re-established, monumented, re-monumented, recovered, found as expressed below:

Grid table with columns A-M and rows 2-13. A triangle marker is present at the intersection of column J and row 8.

NOTE: Not more than 4 corners, all in the same town and range, may be recorded on this certificate.

A. Description of original monument and accessories and/or subsequent restoration: Original Monument: Set post corner to Fr. 1. Sections 23 & 24, 15.57 chains East of 42nd Mile Post (Brookfield, 1827)

Accessories: 15" White Oak, N 26.5° E - 1.13 chains 6" Burr Oak, N 40.5° W - 1.25 chains

Subsequent Restoration: (1) Found 1/2" iron pipe (notes obtained from Brads-ko Eng. & Sur., Inc. dated 2/22/89) (2) Found iron pipe (Survey for Porter by Marbach & Brady, 2/22/94)


B. Description of corner evidence found and/or method applied in restoring or reestablishing corner:

Evidence Found: Found iron pipe (J-8) Found rebar

Distance (J-8) to (K-8): 2648.13' (Notes obtained from Brads-ko dated 2/22/89) 2647.74' (Survey for Porter by Marbach & Brady, 2/22/94) 2647.98' (Marbach & Brady, 1995)

C. Description of monument for corner and accessories established to perpetuate locating the position of the corner: Monument: Replaced pipe with concrete monument (36" long)/rebar with aluminum tablet 6" above ground. Concrete had to be broken off at bottom due to extensive tree roots (rebar remained). Tablet is stamped "Cass County Remonumentation" and is accepted as a careful and faithful reestablishment of the original corner.

Accessories: Masonry nail in fence corner post, N 0° E - 2.10' Masonry nail in 12" Mulberry, N 90° W - 2.60' Masonry nail in 12" Mulberry, N 90° E - 9.64' Masonry nail in 12" Mulberry, N 10° E - 10.85'

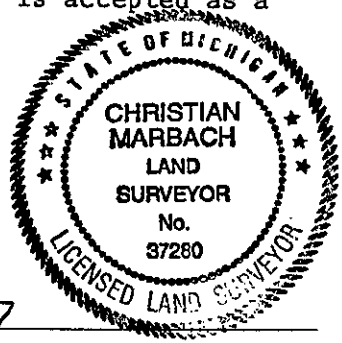

Signed by [Signature] Date Feb 12, 1997

Surveyor's Michigan License No. 37280