63	SURVEY.&
RE	SURVEY-& MONUMENTATION

FEB 1 9 1998

Liber 00003 Page 0083

 	C-	rı	~~	A 3
 ,,,,,,,,,,,,,,,,,,,,,,,,,,,,,,,,,,,,,,,	( <i>5</i>		w	N.

For corners in Ontwa Township

4. Lot No.

5. Private Claims \_

## LAND CORNER RECORDATION CERTIFICATE

Filing Requirement of Act 74, Mich. P.A. 1970 STATE OF MICHIGAN

•	COUNTY	0F	CASS	
	Regards	be		


10

11

12

02-19-1997 14:20:58

Ann L. Simmons REGISTER OF DEEDS

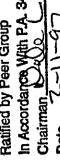


Register of Deeds Stamp & File Number

Cass Located In: Corner Code ## (County) T 8S R 15W 1. Public Land Survey T \_\_\_\_ R \_ \_ R 2. Property Controlling in Section <u>.</u> T \_\_\_ \_ R T \_\_ 3. Miscellaneous Property in Sec.

\_ , Recorded Plat .


I. Christian F. Marbach, in a field survey on September 6 do hereby certify that under requirements of P.A. 74, Michigan P.A. of 1970, the corner points mentioned in lines 1 and 2 above were in conformance with regulations and rules therefore as required in the current manual of survey instructions of the United States Department of the Interior, Bureau of Land Management or by a decree of a Court of Law and/or that the corner points mentioned in lines 3, 4 and 5 above were in conformance with the rules of the Michigan Board of Land Surveyors or by a Decree of a Court of Law; established, re-established, monumented, re-monumented, recovered, found as expressed below:

NOTE: Not more than 4 corners, all in the same town and range, may be recorded on this certificate.

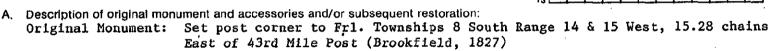

14" White Oak, N 21° W - 31 links Accessories: 14" Yellow Oak, N 67° E - 72 lnks

Subsequent Restoration: None found in records

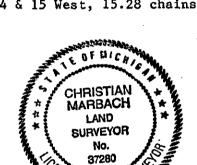

LAND

B. Description of corner evidence found and/or method applied in restoring or reestablishing corner: Evidence Found: Nothing found

(Sketch on reverse side)

(A-8) to  $(B-8) = 2638.74^{\circ}/40$  chains x 29.29 chains = 1931.56' (L-8) established 2608.77' East of (K-8) (L-8) to (M-8) = 2616.35

Description of monument for corner and accessories established to perpetuate locating the position of the corner: Monument: Concrete monument (36" long)/rebar with aluminum tablet, set flush with ground.

Tablet is stamped "Cass County Remonumentation" and is accepted as a careful and faithful reestablishment of the position of the original corner.

Accessories: Monument set in 4 strand barbed wire fence.

Nail in cap set in 6" Wild Cherry, S  $20^\circ$  E -  $3.12^\circ$  Nail in cap set in 15" Oak, S  $40^\circ$  W -  $26.33^\circ$  Nail in cap set in 4" Sassafras, S  $30^\circ$  W -  $25.91^\circ$  Masonry nail set in 6" Oak, N  $30^\circ$  E -  $11.33^\circ$ 

I Mall Date FEB 12, 1997

Surveyor's Michigan License No. \_\_\_\_\_

FORM APPROVED BY MICHIGAN STATE BOARD OF LAND SURVEYORS, JAN. 25, 1971 REVISED MAY 14, 1975

REVISED JAN., 1983

## B. (Sketch)

\* (Clark, 1828)

\*\* (Peirce, 12/10/68)

\*\*\* (Marbach & Brady, 1995)

T85 R15W - T85 R14W

2608.77'

\*\* 2608.77'

\*\* 2608.77'

\*\* 2608.77'

\*\* 2616.35'

1931.56'

\*\* 2638.74'

Liber 00003 Page 0084