

CASS COUNTY REMONUMENTATION
LAND CORNER RECORDATION CERTIFICATE
Filing Requirement of Act 74, Mich. P.A. 1970

For corners in MILTON TOWNSHIP

<u>CASS</u> (County)	Located In:	Corner Code #:
1. Public Land Survey	T <u>8S</u> R <u>16W</u>	<u>C-9</u>
	T _____ R _____	_____
	T _____ R _____	_____
	T _____ R _____	_____
2. Property Controlling in Section	S _____ T _____ R _____	_____
	S _____ T _____ R _____	_____
3. Miscellaneous Property in Sec.	S _____ T _____ R _____	_____
	S _____ T _____ R _____	_____

STATE OF MICHIGAN
COUNTY OF CASS
Recorded

12-22-1999 12:37

Ann L. Simmons
REGISTER OF DEEDS

Register of Deeds Stamp & File Number

Ratified by Peer Group

In Accordance With P.A. 345

Chairman *[Signature]*

- 4. Lot No. _____, Recorded Plat _____
- 5. Private Claims _____

A	B	C	D	E	F	G	H	I	J	K	L	M
2	6	5	4	3	2	1						
3												
4	7	8	9	10	11	12						
5												
6	18	17	16	15	14	13						
7												
8	19	20	21	22	23	24						
9												
10	30	29	28	27	26	25						
11												
12	31	32	33	34	35	36						
13												

CHRISTIAN F. MARBACH in a field survey on DECEMBER 7, 19 99, do hereby certify that under requirements of P.A. 74, Michigan P.A. of 1970, the corner points mentioned in lines 1 and 2 above were in conformance with regulations and rules therefore as required in the current manual of survey instructions of the United States Department of the Interior, Bureau of Land Management or by a decree of a Court of Law and/or that the corner points mentioned in lines 3, 4 and 5 above were in conformance with the rules of the Michigan Board of Land Surveyors or by a Decree of a Court of Law; established, re-established, monumented, re-monumented, recovered, found as expressed below:

NOTE: Not more than 4 corners, all in the same town and range, may be recorded on this certificate.

A. Description of original monument and accessories and/or subsequent restoration:

ORIGINAL MONUMENT: SET POST CORNER TO FRACTIONAL SEC. 19 & 20 6.19 CHAINS EAST OF 32nd MILE POST (BROOKFIELD, 1828)

ACCESSORIES: 18" WHITE OAK N 86°W 92 LINKS
10" YELLOW OAK N 35°E 41 LINKS

SUBSEQUENT RESTORATION: SET STONE ABOVE POST (AMOS SMITH 1882)
SET STONE ABOVE POST (F.E. SMITH 1-5-1897)
FOUND STONE (ABONMARCHE 1975)
FOUND STONE (HARNER 6-3-77)


B. Description of corner evidence found and/or method applied in restoring or reestablishing corner:

EVIDENCE FOUND: FOUND STONE AS DESCRIBED ABOVE

RF

FEB 24 2000

SECTION

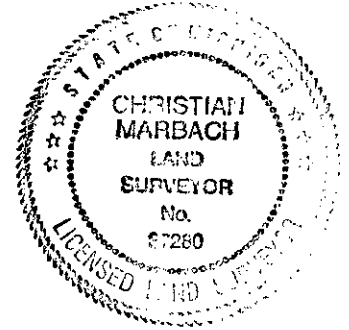

C. Description of monument for corner and accessories established to perpetuate locating the position of the corner:

MONUMENT: CONCRETE MONUMENT (36" LONG/REBAR WITH ALUM. TABLET) TABLET IS STAMPED "CASS COUNTY REMONUMENTATION". SET OVER FOUND STONE AND IS ACCEPTED AS A CAREFUL AND FAITHFUL PERPETUATION OF THE POSITION OF THE ORIGINAL CORNER.

PK IN NORTH SIDE 8" SASSAFRASS N 85°W-12.93'
 PK IN WEST SIDE 30" OAK N 5°E-6.90'
 PK IN NORTH SIDE 8" SASSAFRASS CLUSTER N 89°E-18.41'
 SW CORNER OF ELECTRIC TRANSFORMER S 88°E 20.75'

NORTH SIDE OF ROAD BEHIND MAILBOX 17409 & 17404

Signed by *[Signature]* Date 12/21/99

Surveyor's Michigan License No. 37280