

NOV 16 2000

SECTION

LAND CORNER RECORDATION CERTIFICATE
Filing Requirement of Act 74, Mich. P.A. 1970
CASS COUNTY REMONUMENTATION

For corners in CASS (County) Located In: Corner Code #
1. Public Land Survey T 8S R 16W G1
NE COR. SEC 4
NW COR. SEC 3
2. Property Controlling in Section S T R
3. Miscellaneous Property in Sec. S T R

STATE OF MICHIGAN COUNTY OF CASS Recorded 11-29-1999 13:47:47 Ann L. Simmons REGISTER OF DEEDS
Register of Deeds Stamp & File Number
Ratified by Peer Group In Accordance With P.A. 345 Chairman Date 11/19/99

4. Lot No. , Recorded Plat
5. Private Claims

I, DALE L. KESLER, in a field survey on MARCH 16, 1999 do hereby state that under requirements of P.A. 74, Michigan P.A. of 1970, the corner points mentioned in lines 1 and 2 above were in conformance with regulations and rules therefore as required in the current manual of survey instructions of the United States Department of the Interior, Bureau of Land Management or by a decree of a Court of Law and /or that the corner points mentioned in lines 3, 4 and 5 above were in conformance with the rules of the Michigan Board of Land Surveyors or by a Decree of a Court of Law; established, re-established, monumented, recovered, found as expressed below:

Grid table with columns A-M and rows 1-13. Cell G7 contains a black dot.


NOTE: Not more than 2 corners, all in the same town and range, may be recorded on this certificate.

- A. Description of original monument and accessories and/or subsequent restoration:
* 1827 WILLIAM BROOKFIELD. SET POST. 36" W. OAK N 85 E 3.77, 12" HICKORY N 88 3/4 DEG W 5.41.
* OCTOBER 12, 1874 BRADT COUNTY SURVEYOR. FOUND NW SECTION CORNER. REWITNESS 4" W OAK N 9 DEG E.
* MAY 1954 H.L. DREHER. FOUND CORNER POST USED AS SECTION CORNER MEASURED NORTH 330 FEET SET CORNER AND 2661.0 TO THE WEST 1/4 CORNER FOUND STONE.

Liber 00003 Page 0232

B. Description of corner evidence found and/or method applied in restoring or reestablishing corner:
FOUND POST LYING DOWN AS INDICATED FROM A SURVEY BY H.L. DREHER DATED 1954. RESTORED CORNER FROM THE SURVEY DONE BY H.L. DREHER. MEASURED EAST TO THE 1/8 CORNER AND SOUTH 1/4 CORNER SECTION 3, T8S, R16W TO COMPARE MEASUREMENTS. MEASURED SOUTH FROM THE WEST 1/4 CORNER THROUGH A PROPERTY CORNER ON THE WEST LINE OF SAID SECTION 34 CONTINUED SOUTH THROUGH THE PROPERTY CORNER 330.0 FEET, RECORD, TO SET THE CORNER.

C. Description of monument for corner and accessories established to perpetuate locating the position of the corner:
SET 3" X 36" CONCRETE MONUMENT WITH ALUMINUM CAP AND IS ACCEPTED AS THE BEST AVAILABLE EVIDENCE OF THE POSITION OF THE ORIGINAL CORNER.
SET PK NAIL SOUTHSIDE R.R. TIE FENCE POST N 70 DEG W 11.31'
SET PK NAIL SOUTHSIDE RR TIE LINE POST N 80 DEG W 25.73'
SET PK NAIL IN EAST SIDE 28" BOXELDER S 45 DEG W 18.78'
SET PK NAIL 18" MULBERRY S 45 DEG E 27.57'

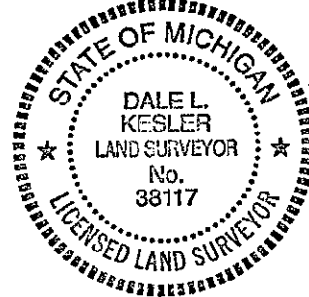

Signed by [Signature]
Surveyor's Michigan License No. 38117

Date 11/23/99