

**CASS COUNTY REMONUMENTATION
LAND CORNER RECORDATION CERTIFICATE**
Filing Requirement of Act 74, Mich. P.A. 1970

For corners in **MILTON TOWNSHIP**

<u>CASS</u> (County)	Located In:	Corner Code #
1. Public Land Survey	T <u>8S</u> R <u>16W</u>	<u>G-9</u>
	T _____ R _____	_____
	T _____ R _____	_____
	T _____ R _____	_____
2. Property Controlling in Section	S _____ T _____ R _____	_____
	S _____ T _____ R _____	_____
3. Miscellaneous Property in Sec.	S _____ T _____ R _____	_____
	S _____ T _____ R _____	_____
4. Lot No. _____, Recorded Plat _____		
5. Private Claims _____		

STATE OF MICHIGAN
COUNTY OF CASS
Recorded
12-22-1999 12:38:54
Ann L. Simmons
REGISTER OF DEEDS
Register of Deeds Stamp & File Number

Ratified By Peer Group
 In Accordance With P.A. 345
 Chairman Dale C. [Signature]

	A	B	C	D	E	F	G	H	I	J	K	L	M
2	6	5	4	3	2	1							
3													
4	7	8	9	10	11	12							
5													
6	18	17	16	15	14	13							
7													
8	19	20	21	22	23	24							
9													
10	30	29	28	27	26	25							
11													
12	31	32	33	34	35	36							
13													

CHRISTIAN F. MARBACH in a field survey on DECEMBER 7, 1999, do hereby certify that under requirements of P.A. 74, Michigan P.A. of 1970, the corner points mentioned in lines 1 and 2 above were in conformance with regulations and rules therefore as required in the current manual of survey instructions of the United States Department of the Interior, Bureau of Land Management or by a decree of a Court of Law and/or that the corner points mentioned in lines 3, 4 and 5 above were in conformance with the rules of the Michigan Board of Land Surveyors or by a Decree of a Court of Law; established, re-established, monumented, re-monumented, recovered, found as expressed below:

NOTE: Not more than 4 corners, all in the same town and range, may be recorded on this certificate.

A. Description of original monument and accessories and/or subsequent restoration:

ORIGINAL MONUMENT: SET POST CORNER TO FRACTIONAL SEC. 21 & 22 8.32 CHAINS E. OF 34th MILE POST (BROOKFIELD, 1878)


**ACCESSORIES: 12" YELLOW OAK S 73° W 37 LINKS
9" HICKORY N 53° E 74 LINKS**

SUBSEQUENT RESTORATION: SET 3/4" IRON PIPE (STEVENSON 1993) NO WITNESSES

B. Description of corner evidence found and/or method applied in restoring or reestablishing corner:

EVIDENCE FOUND: 3/4" IRON PIPE AS DESCRIBED ABOVE

RF
FEB 24 2000
SECTION

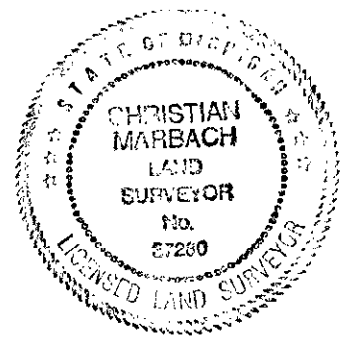

C. Description of monument for corner and accessories established to perpetuate locating the position of the corner:

MONUMENT: CONCRETE MONUMENT (36" LONG/REBAR WITH ALUM. TABLET) TABLET IS STAMPED "CASS COUNTY REMONUMENTATION", AND IS ACCEPTED AS THE BEST AVAILABLE EVIDENCE OF THE POSITION OF THE ORIGINAL CORNER.

**PK IN SOUTH SIDE 12" OAK S 85° W 26.9'
HIGH POINT IN ROCK N 1° W 9.3'
PK IN EAST SIDE 18" SASSAFRASS S 0° E 13.3'
PK IN SOUTH FACE 12" SASSAFRASS N 90° E 36.6'
MON. IS 5' NORTH OF GRAVEL DRIVE**

Signed by [Signature] Date 12/21/99
Surveyor's Michigan License No. 37280