

**SURVEY & REMONUMENTATION**

**FEB 19 1998**

**SECTION**

**LAND CORNER RECORDATION CERTIFICATE**  
Filing Requirement of Act 74, Mich. P.A. 1970  
**CASS COUNTY REMONUMENTATION**

Liber **00003** Page **0140**

STATE OF MICHIGAN  
COUNTY OF CASS  
Recorded

12-26-1997 11:59:44

Ann L. Simmons  
REGISTER OF DEEDS

Printed by Peer Group  
in accordance with P.A. 345  
Chairman Dale Kesler  
Date 11/13/1997

**Register of Deeds Stamp & File Number**

For corners in <u>CASS</u> (County)	Located In:	Corner Code #
1. Public Land Survey MILTON TOWNSHIP	T <u>8S</u> R <u>16W</u>	<u>1-1</u>
	T _____ R _____	_____
	T _____ R _____	_____
	T _____ R _____	_____
2. Property Controlling in Section	S _____ T _____ R _____	_____
	S _____ T _____ R _____	_____
3. Miscellaneous Property in Sec.	S _____ T _____ R _____	_____
	S _____ T _____ R _____	_____

4. Lot No. \_\_\_\_\_, Recorded Plat \_\_\_\_\_  
5. Private Claims \_\_\_\_\_

I, Dale L. Kesler, in a field survey on OCT. 22, 1997 do hereby state that under requirements of P.A. 74, Michigan P.A. of 1970, the corner points mentioned in lines 1 and 2 above were in conformance with regulations and rules therefore as required in the current manual of survey instructions of the United States Department of the Interior, Bureau of Land Management or by a decree of a Court of Law and /or that the corner points mentioned in lines 3, 4 and 5 above were in conformance with the rules of the Michigan Board of Land Surveyors or by a Decree of a Court of Law; established, re-established, monumented, recovered, found as expressed below:

**NOTE: Not more than 2 corners, all in the same town and range, may be recorded on this certificate.**

A. Description of original monument and accessories and/or subsequent restoration:

\*1827 William Brookfield. Set Post. Witnesses: 13" Oak N 72 degrees W 91 lks., 18" Oak N 55 3/4 degrees E 80 lks.

\*June 18, 1874 J.E. Bradt, County Surveyor. Identified corner, re-marked. Witnesses: 4" Oak S 89 degrees E 7 lks.

\*June 26, 1997 Wightman-Peirce, Inc. Found stone with cross. Witnesses: Center of 5 1/2" steel post in con. S 0.8', 10" Oak N 15 degrees E 23.3', Oak S 22 degrees E 21.0', RR tie fence corner post 31.5'

B. Description of corner evidence found and/or method applied in restoring or reestablishing corner:


Found stone with cross on top. Accepted stone as best evidence of corner.

C. Description of monument for corner and accessories established to perpetuate locating the position of the corner:

Set concrete monument with aluminum cap in place of stone and is accepted as a careful and faithful perpetuation of the original corner.

- Center of 5 1/2" steel post in concrete Southwest 0.80'
- Nail & Tag 10" Oak N 15 degrees E 23.30'
- Nail & Tag 18" Oak S 22 degrees E 21.0'
- RR tie Corner post South 31.5'
- 1/2" iron bar 4.0' East 1/2" bar 4.0' South

	A	B	C	D	E	F	G	H	I	J	K	L	M
1													
2	6		5		4		3		2		1		
3													
4	7		8		9		10		11		12		
5													
6	18		17		16		15		14		13		
7													
8	19		20		21		22		23		24		
9													
10	30		29		28		27		26		25		
11													
12	31		32		33		34		35		36		
13													

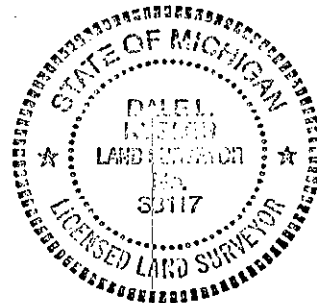

Signed by Dale Kesler

Date 12/4/97

Surveyor's Michigan License No. 38117