

Ratified by Peer Group
 In Accordance With P.A. 345
 Chairman Dale Kesler
 Date December 12, 1995

Liber 00003 Page 0027

LAND CORNER RECORDATION CERTIFICATE
 Filing Requirement of Act 74, Mich. P.A. 1970
CASS COUNTY REMONUMENTATION

STATE OF MICHIGAN
 COUNTY OF CASS
 Recorded

12-28-1995 09:09:10

Ann L. Simmons
 REGISTER OF DEEDS

For corners in

CASS (County)	Located In:	Corner Code #
1. MILTON TWP. Public Land Survey	T <u>8</u> R <u>16</u>	<u>M-7</u>
	T _____ R _____	_____
	T _____ R _____	_____
	T _____ R _____	_____
2. Property Controlling in Section	S _____ T _____ R _____	_____
	S _____ T _____ R _____	_____
3. Miscellaneous Property in Sec.	S _____ T _____ R _____	_____
	S _____ T _____ R _____	_____
4. Lot No. _____, Recorded Plat _____		
5. Private Claims _____		

Register of Deeds Stamp & File Number

	A	B	C	D	E	F	G	H	I	J	K	L	M
2	6		5		4		3		2		1		
3													
4	7		8		9		10		11		12		
5													
6	18		17		16		15		14		13		
7													
8	19		20		21		22		23		24		
9													
10	30		29		28		27		26		25		
11													
12	31		32		33		34		35		36		
13													

I, DALE L. KESLER, in a field survey on November 27, 19 95, do hereby certify that under requirements of P.A. 74, Michigan P.A. of 1970, the corner points mentioned in lines 1 and 2 above were in conformance with regulations and rules therefore as required in the current manual of survey instructions of the United States Department of the Interior, Bureau of Land Management or by a decree of a Court of Law and/or that the corner points mentioned in lines 3, 4 and 5 above were in conformance with the rules of the Michigan Board of Land Surveyors or by a Decree of a Court of Law; established, re-established, monumented, re-monumented, recovered, found as expressed below:


NOTE: Not more than 4 corners, all in the same town and range, may be recorded on this certificate.

- A. Description of original monument and accessories and/or subsequent restoration:
- JULY 11, 1828 - William Brookfield - Set Post - No witnesses
 - 1932 +/- Cass County Road Commission
 - JUNE & JULY 1971, MAY & JUNE 1972 - D. M. Dreher - Found iron over stone - Fence corner, post NE 44.85' - Fence corner, post SW 43.75' - Fence corner post SE 47.55' - Telephone Cable marker, NW 54.9'
 - JUNE 16, 1972 - D.M. Dreher - Recorded L.C.R.C. Liber 1, page 15, Found Stone - Set 3/4" iron pipe over stone - Corner, post NE 44.85' - Corner, post SW 43.75' - Corner, post SW 47.55' - Center pavement South 4.4'
- B. Description of corner evidence found and/or method applied in restoring or reestablishing corner: (Over)

Found standard monument in a monument box. Accepted standard monument as best evidence of corner.

MAR 27 1996
 COMMISSION

- C. Description of monument for corner and accessories established to perpetuate locating the position of the corner:
- Set 3/4" X 24" iron pipe with aluminum cap in place of standard monument and is accepted as a careful and faithful perpetuation of the original corner.
 - Centerline East & West asphalt road - South 4.40'
 - Nail w/washer on south side light pole - N. 45° E. 45.60'
 - Nail w/washer in guy wire pole - N. 65° E. 91.90'
 - Northeast corner of house - S. 35° W. 137.40'
 - Nail w/washer - 24" Elm S. 30° W. 89.30'

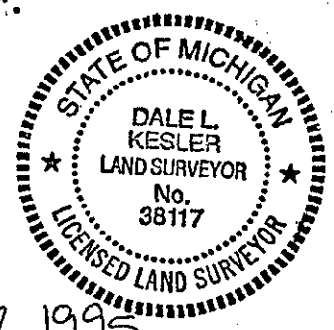

Signed by Dale L. Kesler Date December 27, 1995
 Surveyor's Michigan License No. No. 38117

A. Continued

OCT. 28, 1978 - Douglas Peirce - Recorded - L.C.R.C. Liber 2, Page 128 - Set Standard
Monument - 6" elm N. 46° W. 78.42' - 4" Steel post N. 50° W. 57.45'