

LAND CORNER RECORDATION CERTIFICATE

FILING REQUIREMENT OF ACT 74, MICH. P.A. 1970

CHIPPEWA CO.

1 Corner

| FOR CORNERS OF--: | LOCATED IN--: | CORNER CODE NUMBER |
|--|---|--------------------|
| 1. PUBLIC LAND SURVEY _____ | T. <u>41</u> N. <u>9</u> R. <u>6</u> E. <u>W</u> | <u>E-3</u> |
| 2. PROPERTY CONTROLLING IN SECTION _____ | T. _____ N. _____ S. _____ R. _____ E. _____ W. _____ | _____ |
| 3. MISCELLANEOUS PROPERTY IN SECTION _____ | T. _____ N. _____ S. _____ R. _____ E. _____ W. _____ | _____ |
| 4. LOT NO. _____, RECORDED PLAT _____ | | |
| 5. PRIVATE CLAIMS _____ | | |

REGISTER OF DEEDS STAMP AND
FILING NUMBER

I, Gerald L. Wiggins, do hereby certify that under requirements of P.A. 74, Michigan P.A. of 1970, the corner points mentioned in lines 1 and 2 above were, in a field survey on October 15, 1987, established, re-established, monumented, re-monumented, recovered or restored as expressed below and in conformance with regulations and rules therefore as required in the current manual of survey instructions of the United States Department of the Interior, Bureau of Land Management or by a decree of a court of law. Furthermore, that the corner points mentioned in lines 3, 4 and 5 above were, in a field survey on _____, 19____, found, recovered, restored, established or re-established as expressed below and in conformance with the rules of the Michigan State Board of Registration for Land Surveyors or, by a Decree of a Court of law:

A. Description of original monument and accessories and/or subsequent restoration:

E-3 N.W. Section Corner of Section 9. O.B.T.'S.: Cedar 12, N68⁰W, 16 lks. & Birch 8, S36⁰E, 21 lks.

E-3 B. Description of corner evidence found and/or method applied in restoring or re-establishing corner:
Set this corner at a found 3/4" X 24" Iron. Found this Iron under a rotten Balsam Tree that had fallen on top of it. (Found this Iron 4-26-85). Gerald Gabel R.L.S. #10325 has a recorded corner he set at a Sq. Post N82⁰E, 80.80' from this Iron. Setting this corner at found Iron makes the proportion distance of 2233.0' East to a Rock Ledge fit the record distance of 2232.0'. It also makes the 2 miles East to a good corner fit record distance. As well as the 2 miles west to an original corner fit record distance.

E-3 C. Description of monument for corner and accessories established to perpetuate locating the position of the corner:
DNR MONUMENT SET AT THIS CORNER.


8" Spruce, N26⁰W, 7.3' & 8" Cedar, N16⁰E, 34.10'

10' Cedar, N80⁰E, 8.75' & 14" R. Pine, S20⁰E, 70.30'

"T" Iron #10325 1 1/4" Drill Rod, N82⁰E, 80.8'

SIGNED BY Gerald L. Wiggins
Gerald L. Wiggins
SURVEYOR'S MICHIGAN REGISTRATION NO. 23521

DATE 5-18-87

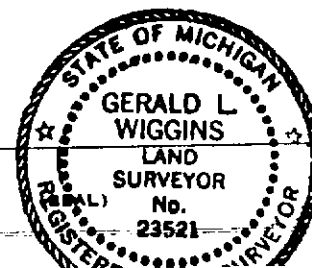

FOR STATE AND UNITED STATES AGENCIES: