

LAND CORNER RECORDATION CERTIFICATE

FILING REQUIREMENT OF ACT 74, MICH. P.A.1970

CHIPPEWA CO.

3 CORNERS.

FOR CORNERS OF--:	LOCATED IN--:	CORNER CODE NUMBER
1. PUBLIC LAND SURVEY_____	T. 41 N. R. 6 W.	B-3
2. PROPERTY CONTROLLING IN SECTION 6	, T. 41 N. R. 6 W.	15, 16
3. MISCELLANEOUS PROPERTY IN SECTION _____	, T. _____ S. R. _____ W.	
4. LOT NO. _____, RECORDED PLAT _____		
5. PRIVATE CLAIMS _____		

REGISTER OF DEEDS STAMP AND FILING NUMBER

I, Gerald L. Wiggins, do hereby certify that under requirements of P.A. 74, Michigan P.A. of 1970, the corner points mentioned in lines 1 and 2 above were, in a field survey on 5-18 & 5-19, 1987, established, re-established, monumented, re-monumented, recovered or restored as expressed below and in conformance with regulations and rules therefore as required in the current manual of survey instructions of the United States Department of the Interior, Bureau of Land Management or by a decree of a court of law. Furthermore, that the corner points mentioned in lines 3, 4 and 5 above were, in a field survey on _____, 19____, found, recovered, restored, established or re-established as expressed below and in conformance with the rules of the Michigan State Board of Registration for Land Surveyors or, by a Decree of a Court of law:

A. Description of original monument and accessories and/or subsequent restoration:

B-3 South 1/4 Corner of Section 6. OBT'S: Cedar 6", N02°W, 13 lks. & Cedar 8", S41°E, 9 lks.

15 West 1/16 Corner on South side of Section 6. Not prev. set.

16 East 1/16 Corner on South side of Section 6. Not prev. set.

B. Description of corner evidence found and/or method applied in restoring or re-establishing corner:

B-3 Corner set by single proportionate measure between the S.W. corner and S.E. Corner of Section 6.

15 Corner set M.P.O.L. between S.W. Corner and South 1/4 Corner of Section 6.

16 Corner set M.P.O.L. between South 1/4 Corner and S.E. Corner of Section 6.


C. Description of monument for corner and accessories established to perpetuate locating the position of the corner:
DNR MONUMENTS PLACED AT ALL THREE CORNERS.

B-3 6" Cedar, N70°W, 13.4'	15 8" Cedar, N38°W, 13.80'	16 8" H. Maple, S05°E, 12.0'
6" Cedar, N33°W, 12.6'	6" Cedar, S78°E, 0.85'	3" Cedar, S56°W, 13.8'
8" Cedar, N10°E, 14.0'	8" Cedar, S19°W, 16.90'	12" Beech, N29°W, 31.5'
6" Cedar, S40°E, 21.4'	7" Cedar, S80°W, 23.85'	12" Y. Birch, N11°E, 22.6'
Sq. Post, South West, 2.3'		Sq. Post, East, 62.1'

SIGNED BY Gerald L. Wiggins
Gerald L. Wiggins

DATE 5-26-87

SURVEYOR'S MICHIGAN REGISTRATION NO. 23521

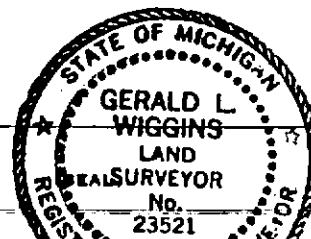

FOR STATE AND UNITED STATES AGENCIES.