


T. 41 N R. 6 E
Section 6

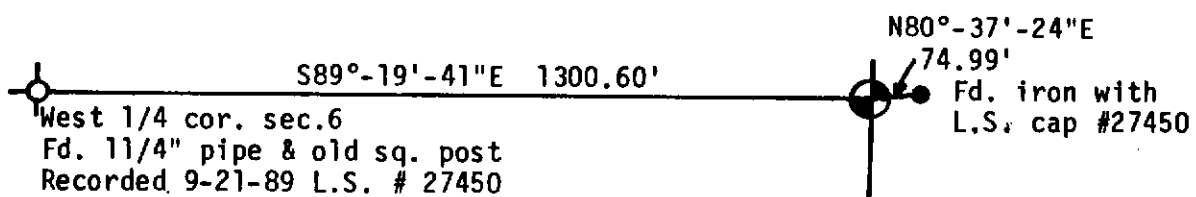

NW 1/4, SW 1/4
SECTION 6

S 01°-26'-30" W 1314.97'

N84°-11'-01"E

125.83'

Fd. iron with
L.S. cap #27450

● Iron w/cap #27450
⊕ D.N.R. Moument

Scale 1" = 300'

Gerald L. Wiggins
Gerald L. Wiggins L.S. # 23521